IREDELL COUNTY HEALTH DEPARTMENT

Thru section to Construct

STATESVILLE 704-878-5305 MOORESVILLE 704-664-5281

40°

IMPROVEMENT PERMIT / ~~CERTIFICATE OF COMPLETION~~ / OPERATION PERMIT / EXISTING SYSTEM INSPECTION

PROPERTY DESCRIPTION NO. 3335 DATE 1/31/96 TAX MAP NO. 2I 18A 52 Watershed: X Yes ☐ No

OWNER OR CONTRACTOR James L Ramsey ~~PHONE: Business~~ 4646-77-1211 Home 786-6721

ADDRESS 2904 Mountcrest Cir. Concord, NC. 28027

LOCATION Hobbs Road, (L) off Beverly Sch onto Hobbs Rd, on (R) at Hickory Hill Cir intersection

SUBDIVISION Hobbs Cove BLOCK / SECTION 1 LOT 52 LOT AREA ~.73 SITE CLASS. PS DESIGN FLOW 480 L.T.A.R. .35

Septic Tank: 1000 Gallons; STB 786 Date 6/4/96

Pump Tank: _____ Gallons; PT _____ Date _____

Pump Make: _____ Model _____ Serial No. _____

Nitrification Field: No Fields 1 Square Feet 1371 Linear Feet 345

No Lines 4 Trench Width 36" Max Trench Bottom Depth 36" Gravel Depth N/A

X New System ☐ Repair System Type: I, II, (III), IV, V, VI

System Description: Gravity - conventional

Repair System Description: _____

Maintenance Agreement Required: ☐ Yes ☐ No

X House/Mod. Home No. Bedrooms 4

☐ Mobile Home No. Bathrooms 3

☐ Business No. Employees _____

☐ Other _____


☐ Slab ☐ Crawl Space X Basement w/plumbing ☐ Basement wo/plumbing

Water Supply: X Individual ☐ Community ☐ Public

Comments: House will contain partial basement - House location shifted to accomodate a gravity drainfield

Comments:

INITIAL SITE SKETCH

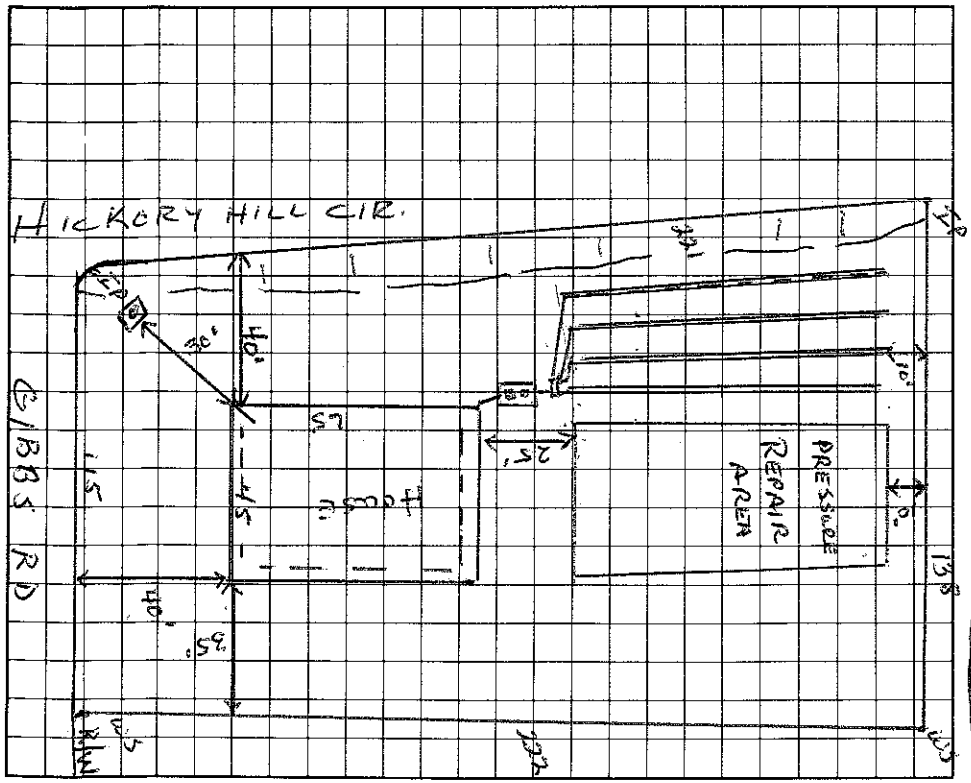

AS BUILT SKETCH

1" = 50'

I understand that this permit can be suspended or revoked if any false information is supplied toward securing the permit/any unauthorized changes are made to the site/any unauthorized changes are made in the installation of the system.

Signed: X Shirley H. Ramsey

Improvement Permit by: Wesley Sparks REHS date 2/1/96

Existing System Inspection by: Construct - Wesley Sparks REHS date 2/1/96

Installed by: Dennis Hoyle

Certificate of Completion by: _____ date _____

Operation Permit by: Wesley Sparks REHS date 8/27/96

HEALTH DEPT. COPY: WHITE INSPECTION COPY (FINAL): GREEN OWNER COPY (FINAL): YELLOW INSPECTION COPY (INITIAL): PINK OWNER COPY (INITIAL): GOLD