IREDELL COUNTY HEALTH DEPARTMENT / Authorization to Construct

STATESVILLE 704-878-5305 MOORESVILLE 704-664-5281

9:30

IMPROVEMENT PERMIT / ~~CERTIFICATE OF COMPLETION~~ / OPERATION PERMIT / EXISTING SYSTEM INSPECTION

PROPERTY DESCRIPTION NO. 3774 DATE 4/30/96 TAX MAP NO. 2J 18 A 55 Watershed: [X] Yes [ ] No

OWNER OR CONTRACTOR Mike Aspe PHONE: Business (w) 4646-77-1653 Home 599-4901

ADDRESS 3410 Atlas Dr. Charlotte, NC. 28269

LOCATION Bubbs Rd. Mooresville, NC 28115

SUBDIVISION Bubbs Cove BLOCK / SECTION 1 LOT 55 LOT AREA .98 AC SITE CLASS. PS DESIGN FLOW 480 L.T.A.R. .35

Septic Tank: 1000 Gallons; STB 249 Date 2/23/95

Pump Tank: _____ Gallons; PT _____ Date _____

Pump Make: _____ Model _____ Serial No. _____

Nitrification Field: No Fields 1 Square Feet 1371 Linear Feet 460

No Lines 4 Trench Width 36" Max Trench Bottom Depth 36" Gravel Depth 12"

[X] New System [ ] Repair System Type: I (II) III, IV, V, VI

System Description: GRAVITY - CONVENTIONAL

Repair System Description: GRAVITY - PLASTIC CHAM.

Maintenance Agreement Required: [ ] Yes [X] No

[X] House/Mod. Home [ ] Mobile Home [ ] Business [ ] Other

No. Bedrooms 4 No. Bathrooms 2.5 No. Employees ____


[ ] Slab [X] Crawl Space [ ] Basement w/plumbing [ ] Basement wo/plumbing

Water Supply: [X] Individual [ ] Community [ ] Public

Comments: 44-47-

Comments:

INITIAL SITE SKETCH

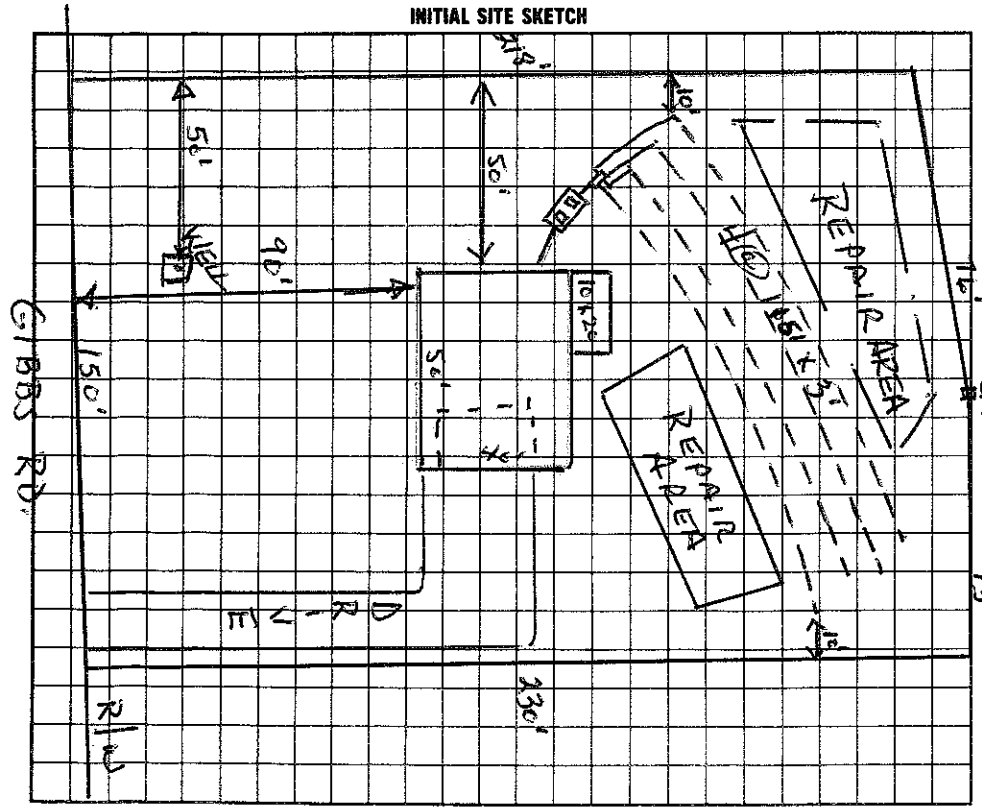

AS BUILT SKETCH

I understand that this permit can be suspended or revoked if any false information is supplied toward securing the permit/any unauthorized changes are made to the site/any unauthorized changes are made in the installation of the system.

Authorization to Construct valid 5 years.

Signed: Jo Ryan

Improvement Permit by: Wesley Sparks RS. date 4/30/96

Authorization to Construct Existing System Inspection by: Wesley Sparks RS. date 4/30/96

Installed by: CL MORRISON

Certificate of Completion by: C. [signature] date 5/23/96

Operation Permit by: _____ date _____

HEALTH DEPT. COPY: WHITE INSPECTION COPY (FINAL): GREEN OWNER COPY (FINAL): YELLOW INSPECTION COPY (INITIAL): PINK OWNER COPY (INITIAL): GOLD