IREDELL COUNTY HEALTH DEPARTMENT

Authorization to Construct (9:30)

STATESVILLE 704-878-5305 MOORESVILLE 704-664-5281

IMPROVEMENT PERMIT / ~~CERTIFICATE OF COMPLETION~~ / OPERATION PERMIT / EXISTING SYSTEM INSPECTION

PROPERTY DESCRIPTION NO. 3631 DATE 5/2/96 TAX MAP NO. 2J 18A 56 Watershed: X Yes ☐ No

OWNER OR CONTRACTOR Douglas King PHONE: Business 542-7450 ~~Home~~ 4646-77-2718

ADDRESS 7500 Cedar Pt Ln. Apt 202 Charlotte NC. 28210

LOCATION Gibbs Rd. (L) off Brawley Sch on (R) past first street to 7th lot on (R)

SUBDIVISION Gibbs Cove BLOCK / SECTION — LOT 56 LOT AREA 2.79Ac SITE CLASS. PS DESIGN FLOW 360 L.T.A.R. .3

Septic Tank: 1000 Gallons; STB 794 Date 11/1/96

Pump Tank: ____ Gallons; PT ____ Date ____

Pump Make: ____ Model ____ Serial No. ____

Nitrification Field; No Fields 1 Square Feet 1200 Linear Feet 400

No Lines 4 Trench Width 36" Max Trench Bottom Depth 36" Gravel Depth 12"

X New System ☐ Repair System Type: I (II) III. IV. V. VI.

System Description: Dust Bowl - Conventional

Repair System Description: Ch Plastic

Maintenance Agreement Required: ☐ Yes X No

X House/Mod. Home ☐ Mobile Home ☐ Business ☐ Other

No. Bedrooms 3 No. Bathrooms 2.5 No. Employees ____


☐ Slab X Crawl Space ☐ Basement w/plumbing ☐ Basement wo/plumbing

Water Supply: X Individual ☐ Community ☐ Public


Comments:

Comments:

INITIAL SITE SKETCH

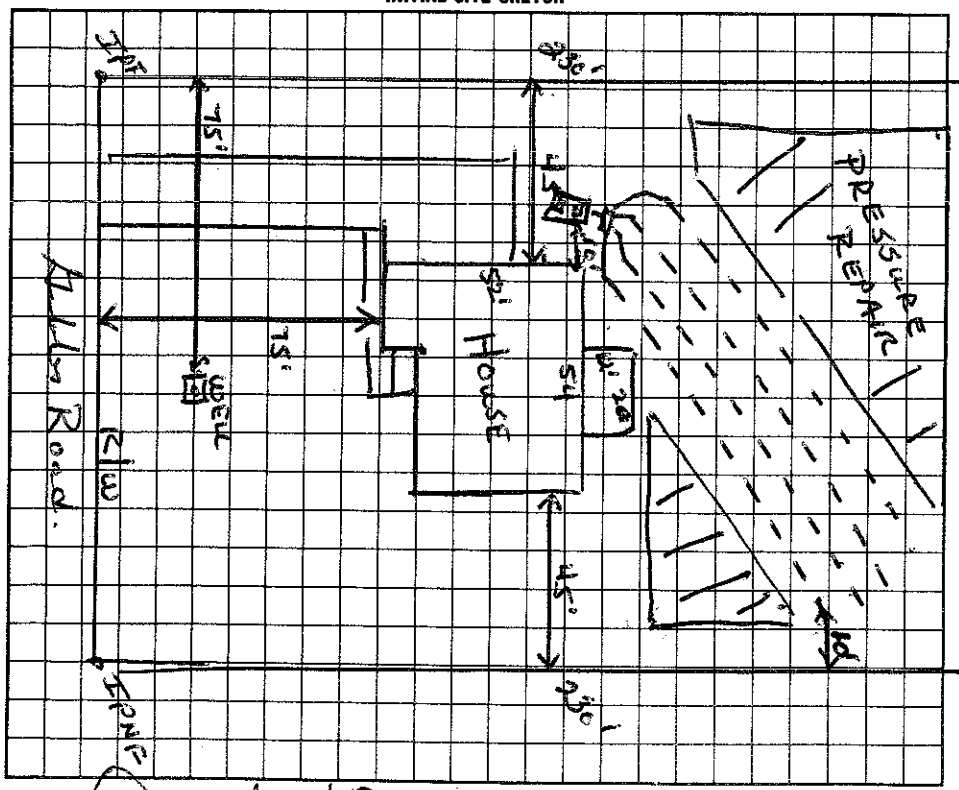

AS BUILT SKETCH

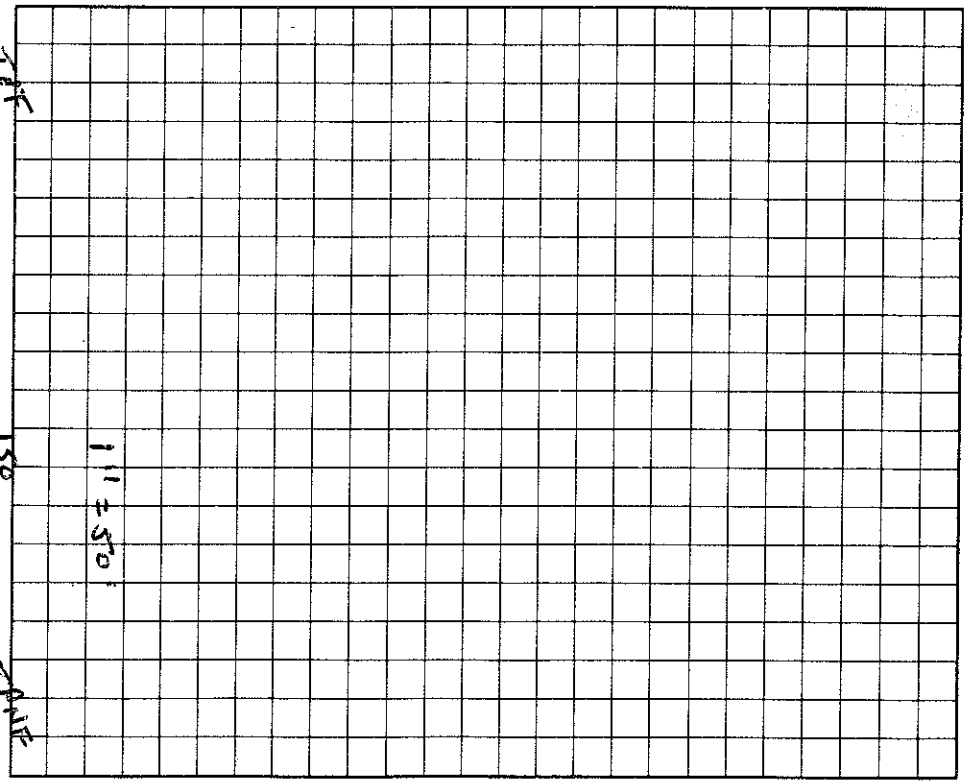

I understand that this permit can be suspended or revoked if any false information is supplied toward securing the permit/any unauthorized changes are made to the site/any unauthorized changes are made in the installation of the system.

Signed: X Douglas King

Installed by: W CUET PUNNING

Improvement Permit by: Wesley Sparks R.S. date 5/2/96

Certificate of Completion by: ____ date ____

Existing System Inspection by: Authorization to Construct Wesley Sparks R.S. date 5/2/96

Operation Permit by: C. Blackburn date 12/23/96

HEALTH DEPT. COPY: WHITE INSPECTION COPY (FINAL): GREEN OWNER COPY (FINAL): YELLOW INSPECTION COPY (INITIAL): PINK OWNER COPY (INITIAL): GOLD