IREDELL COUNTY HEALTH DEPARTMENT

STATESVILLE 704-878-5305 MOORESVILLE 704-664-5281

IMPROVEMENT PERMIT / AUTHORIZATION TO CONSTRUCT / OPERATION PERMIT / EXISTING SYSTEM INSPECTION

PERMIT# 118304 PIN# 4646-78-0045 DATE 3/3/04

OWNER OR CONTRACTOR Shannon Myers PHONE: Business _____ Home 704-239-0059

ADDRESS 637 Williamson Rd Mooresville NC 28117

LOCATION BSR, TL Gibbs, TR Apple Blossom, TL Hickory Hill, on LT

SUBDIVISION Gibbs Cove BLOCK / SECTION _____ LOT 45 LOT AREA 0.6987 AC SITE CLASS. PS DESIGN FLOW 480 L.T.A.R. 0.35

Septic Tank: 1000 Gallons; STB 825 Date 5/10/04

Pump Tank: _____ Gallons; PT _____ Date _____

Pump Make: _____ Model _____ Serial No. _____

Nitrification Field: No Fields 1 Square Feet 1029 Linear Feet 343

No Lines 5 Trench Width 36" Max Trench Bottom Depth 36" Gravel Depth —

☒ New System ☐ Repair System Type: I, II, (III), IV, V, VI

System Description: Gravity 25% Reduct.

Repair System Description: LP Panel Block

Maintenance Agreement Required: ☐ Yes ☐ No

☒ House/Mod. Home No. Bedrooms 4

☐ Mobile Home No. Bathrooms 2½

☐ Business No. Employees _____

☐ Other _____


☐ Slab ☐ Crawl Space ☐ Basement w/plumbing ☐ Basement wo/plumbing

Water Supply: ☒ Individual ☐ Public ☐ Community


Comments:/Conditions:

Comments:/Conditions:

INITIAL SITE SKETCH

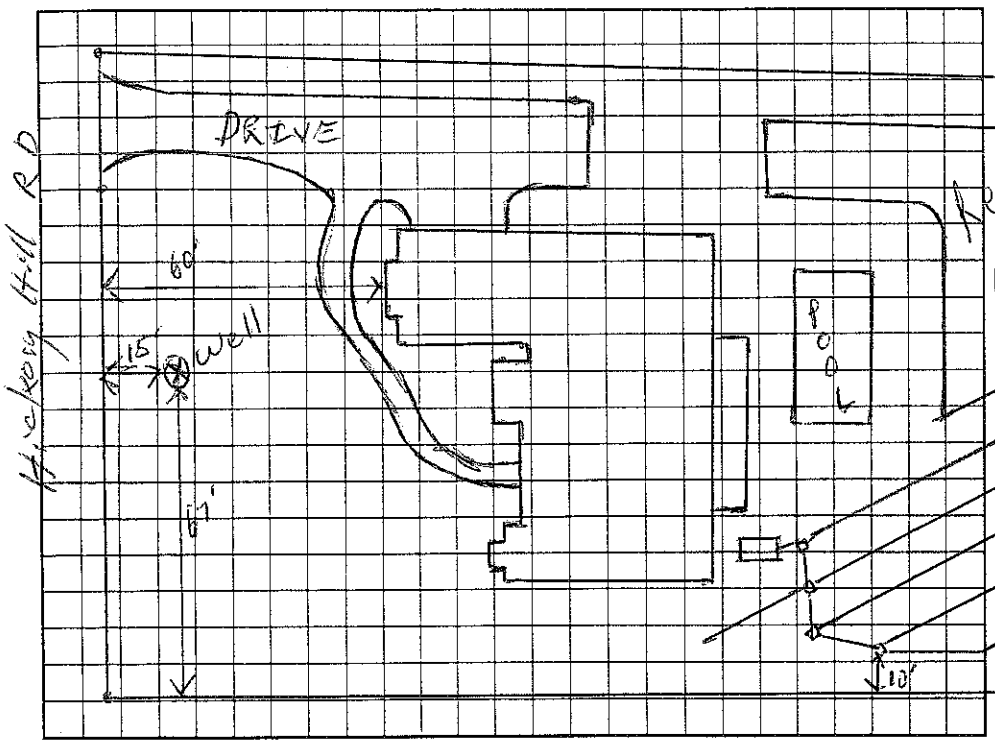

AS BUILT SKETCH

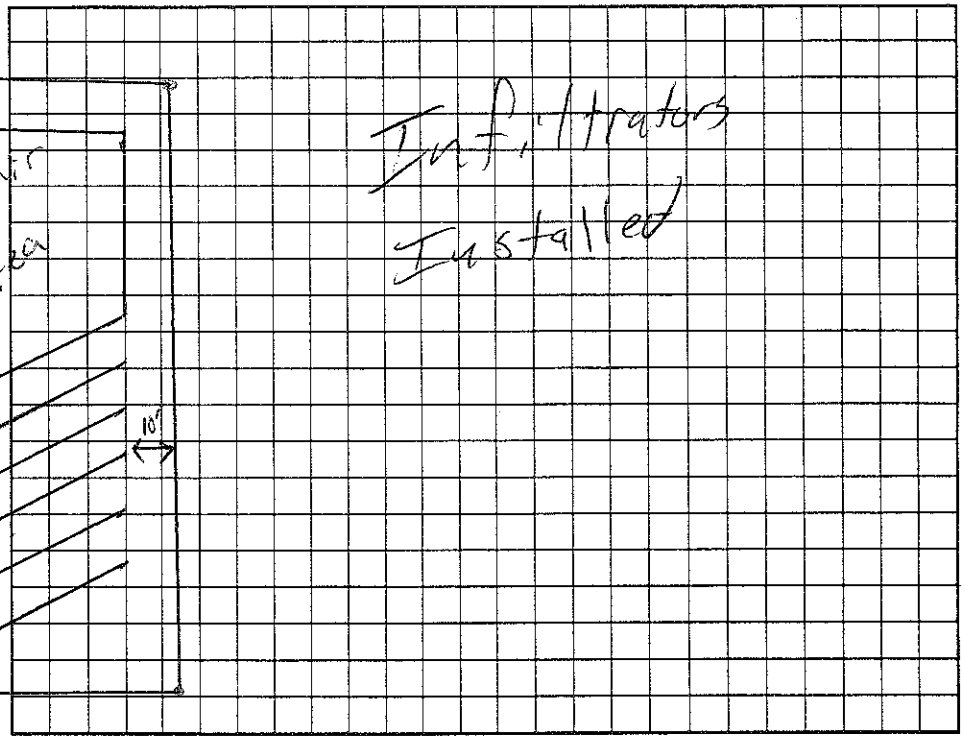

Permit can be suspended or revoked if any false information is supplied toward securing the permit/any unauthorized changes are made to the site/any unauthorized changes are made in the installation of the system. Improvement Permit with plat valid without expiration. Improvement Permit with site plan valid for sixty months. Authorization to Construct is valid for a period equal to that of Improvement Permit – not to exceed sixty months.

Signed: _____ date _____

Improvement Permit by: _____ date 3/3/04

Authorization to Construct by: _____ date 3/9/04

Installed by: Rowan Septic

Operation Permit by: _____ date 7/19/04

Existing System Inspection by: _____ date _____

HEALTH DEPT. COPY: WHITE OWNER COPY (FINAL): YELLOW OWNER COPY (INITIAL): PINK