IREDELL COUNTY HEALTH DEPARTMENT

STATESVILLE 704-878-5305 100.00 Pay MOORESVILLE 704-664-5281

IMPROVEMENT PERMIT / AUTHORIZATION TO CONSTRUCT / OPERATION PERMIT / EXISTING SYSTEM INSPECTION

PERMIT# 119122 PIN# 4646 78 2273 DATE 7/31/06

OWNER OR APPLICANT Karen B Ray PHONE: Business 704 660 5961 Home

ADDRESS 267 Hobbs Rd. Mooresville, NC. 28117

LOCATION Hobbs Rd. TR Apple Blossom TL Hickory Hill, 4th lot on L

SUBDIVISION Hobbs Cove BLOCK / SECTION LOT 43 LOT AREA .88AC SITE CLASS PS DESIGN FLOW 480 L.T.A.R. .3

Septic Tank: 1000V Gallons; STB 312 Date 12/7/05
Pump Tank: Gallons; PT Date
Pump Make: Model Serial No.
Nitrification Field: No Fields 1 Square Feet 1200 Linear Feet 400
No Lines 3@133' Trench Width 3' Max Trench Bottom Depth 3'

☒ New System ☐ Repair ☐ Expansion System Type: I II III IV V VI
System Description: Gravity - 25% Reduction
Repair System Description: Gravity - PPBPS
Maintenance Agreement Required: ☐ Yes ☒ No

☒ House/Mod. Home ☐ Mobile Home ☐ Business ☐ Other
No. Bedrooms 4 No. Persons 4 No. Employees


Water Supply: ☒ Individual ☐ Public ☐ Community

Gravel Depth NA ☒ Gravity ☐ Pressure ☐ Slab ☒ Crawl Space ☐ Basement w/plumbing ☐ Basement wo/plumbing


Comments:/Conditions:

Comments:/Conditions: Installed 2 Infiltrator Quick 4

INITIAL SITE SKETCH

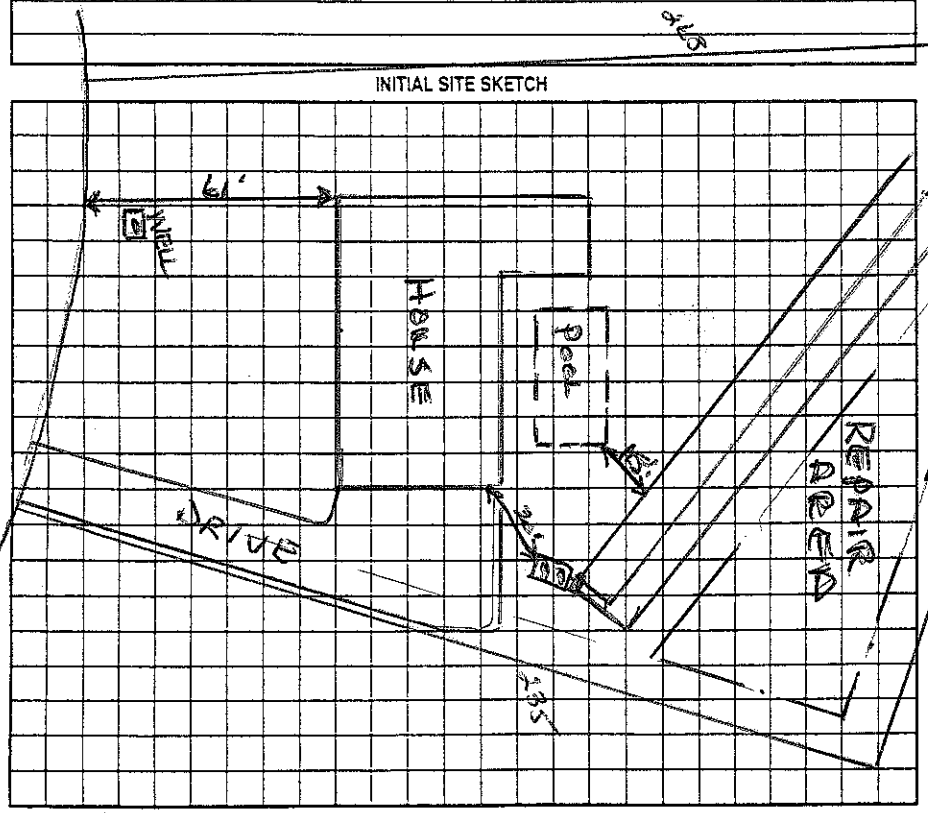

AS BUILT SKETCH

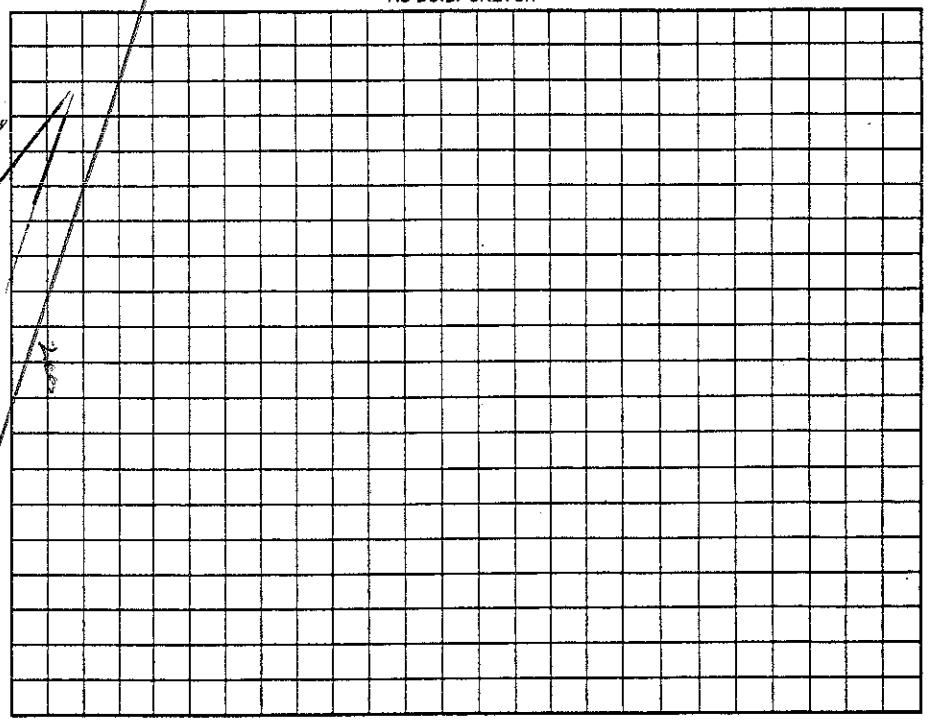

Permit can be suspended or revoked if any false information is supplied toward securing the permit/any unauthorized changes are made to the site/any unauthorized changes are made in the installation of the system. Improvement Permit with plat valid without expiration ☐ Improvement Permit with site plan valid for sixty months ☐ Authorization to Construct is valid for a period equal to that of Improvement Permit – not to exceed sixty months.

Signed: Karen B. Ray date 8/2/06

Improvement Permit by: Wesley Sparks RS. date 7/31/06

Authorization to Construct by: Wesley Sparks RS. date 7/31/06

Installed by: Dellinger Bros.

Operation Permit by: Wesley Sparks RS date 3/6/07

Existing System Inspection by: date

HEALTH DEPT. COPY: WHITE OWNER COPY (FINAL): YELLOW OWNER COPY (INITIAL): PINK