IREDELL COUNTY HEALTH DEPARTMENT

STATESVILLE 704-878-5305 / 130.00 Fa.d / MOORESVILLE 704-664-5281

IMPROVEMENT PERMIT / AUTHORIZATION TO CONSTRUCT / OPERATION PERMIT / EXISTING SYSTEM INSPECTION

PERMIT# 117978 PIN# 4646 78 2535 DATE 3/22/04

OWNER OR CONTRACTOR Vetco Development / George Church PHONE: Business 704-400-9829 Home

ADDRESS 109 Harbor Mooresville, NC. 28117

LOCATION 109 Hickory Hill Rd. Mooresville, NC. 28115

SUBDIVISION Nobles Cove BLOCK / SECTION 2 LOT 41 LOT AREA 30646 FT² SITE CLASS. PS DESIGN FLOW 480 L.T.A.R. .3

Septic Tank: 1000 Gallons; STB 794 Date 3/2/04
Pump Tank: 1000 Gallons; PT 283 Date 5/28/04
Pump Make: _____ Model _____ Serial No. _____
Nitrification Field: No Fields 1 Square Feet 1200 Linear Feet 400
No Lines 4 @ 100' Trench Width 3' Max Trench Bottom Depth 3' Gravel Depth No

[X] New System [ ] Repair System Type: I, II, (III) IV, V, VI
System Description: Pres Manifold → 25% Reduced
Repair System Description: Pres Dosed - 16# PPBPS
Maintenance Agreement Required: [ ] Yes [X] No

[X] House/Mod. Home No. Bedrooms 4
[ ] Mobile Home No. Bathrooms 3
[ ] Business No. Employees
[ ] Other

[ ] Slab [X] Crawl Space [ ] Basement w/plumbing [ ] Basement wo/plumbing


Water Supply: [X] Individual [ ] Public [ ] Community

Comments:/Conditions: Space wasted due to irregular topography emportion of this lot.


Comments:/Conditions: 6/25/04 Drain field

INITIAL SITE SKETCH

1" = 40'

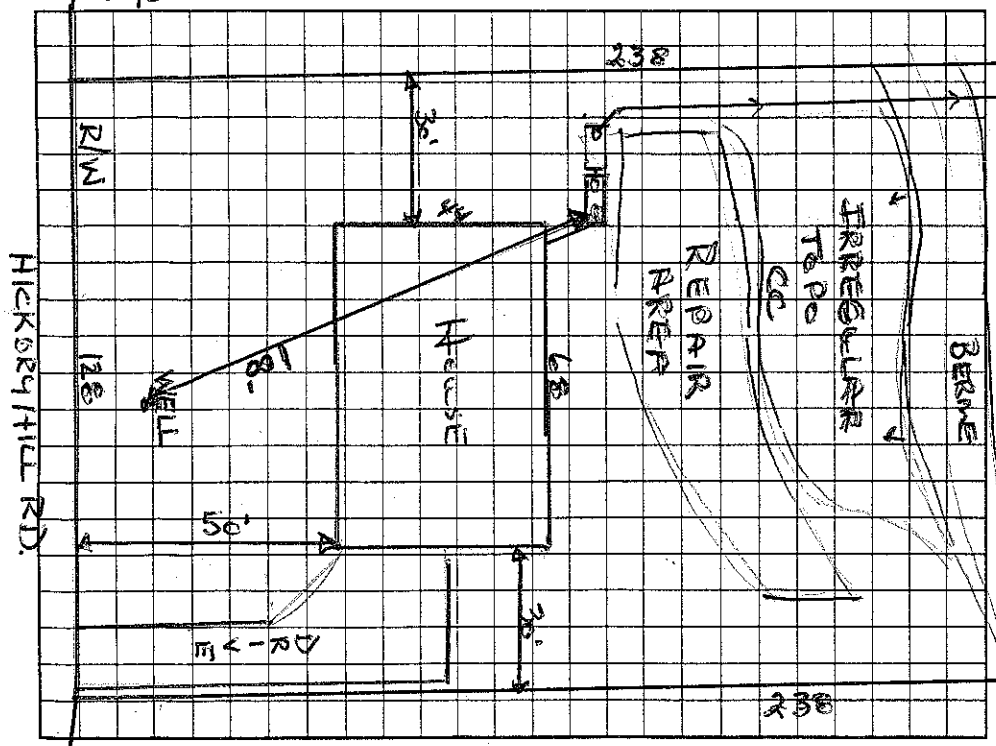

AS BUILT SKETCH

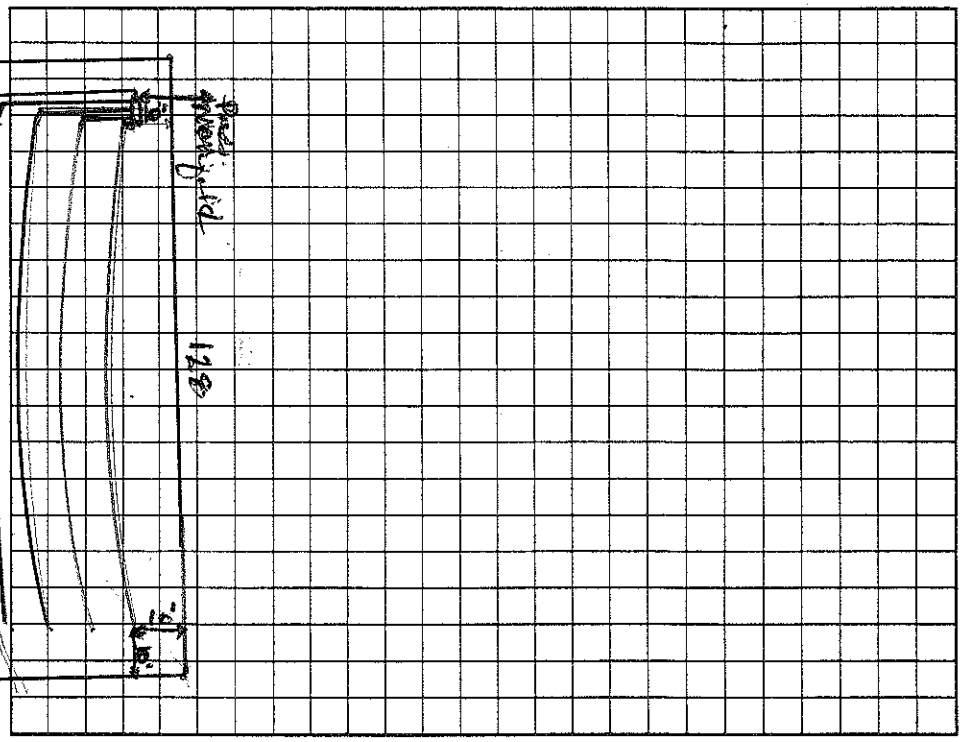

Permit can be suspended or revoked if any false information is supplied toward securing the permit/any unauthorized changes are made to the site/any unauthorized changes are made in the installation of the system. Improvement Permit with plat valid without expiration. Improvement Permit with site plan valid for sixty months. Authorization to Construct is valid for a period equal to that of Improvement Permit -- not to exceed sixty months.

Signed: _____ date 3-25-04 Installed by: Joe Perkins

Improvement Permit by: Wesley Sparks RS. date 3/22/04 Operation Permit by: Wesley Sparks RS. date 11/17/04

Authorization to Construct by: Wesley Sparks RS. date 3/22/04 Existing System Inspection by: _____ date _____

HEALTH DEPT. COPY: WHITE OWNER COPY (FINAL): YELLOW OWNER COPY (INITIAL): PINK