DELL COUNTY HEALTH DEPARTMENT

STATESVILLE 704-878-5305 130.00 Paid MOORESVILLE 704-664-5281

PROVEMENT PERMIT / AUTHORIZATION TO CONSTRUCT / OPERATION PERMIT / EXISTING SYSTEM INSPECTION

PERMIT# 117986 PIN# 4646 78 2720

OWNER OR CONTRACTOR Yelco Development - George Church PHONE: Business 704-400-9829 Home DATE 3/18/04

ADDRESS 109 Harbor Mooresville, NC. 28117

LOCATION 103 Hickory Hill Rd., 1100 Tl Gibbs Rd TR Apple Blossom TL Hickory Hill, corner lot on (L)

SUBDIVISION Gibbs Cove BLOCK / SECTION 2 LOT 40 LOT AREA .74Ac SITE CLASS PS1 DESIGN FLOW 480 L.T.A.R. .3

Septic Tank: 1000 Gallons; STB 312 Date 3/5/04

Pump Tank: 1000 Gallons; PT 293 Date 2/11/04

Pump Make: Model Serial No.

Nitrification Field: No Fields 1 Square Feet 1200 Linear Feet 400

No Lines 3@133' Trench Width 3' Max Trench Bottom Depth 3'

[X] New System [ ] Repair System Type: I, II, [III], IV, V, VI

System Description: PM → Type 3

Repair System Description: Same

Maintenance Agreement Required: [ ] Yes [X] No

Gravel Depth No [ ] Slab [X] Crawl Space [ ] Basement w/plumbing [ ] Basement wo/plumbing

[X] House/Mod. Home No. Bedrooms 4

[ ] Mobile Home No. Bathrooms 3

[ ] Business No. Employees

[ ] Other


Water Supply: [X] Individual [ ] Public [ ] Community

Comments:/Conditions:


Comments:/Conditions: Lines, Tanks

(1"=40')

INITIAL SITE SKETCH

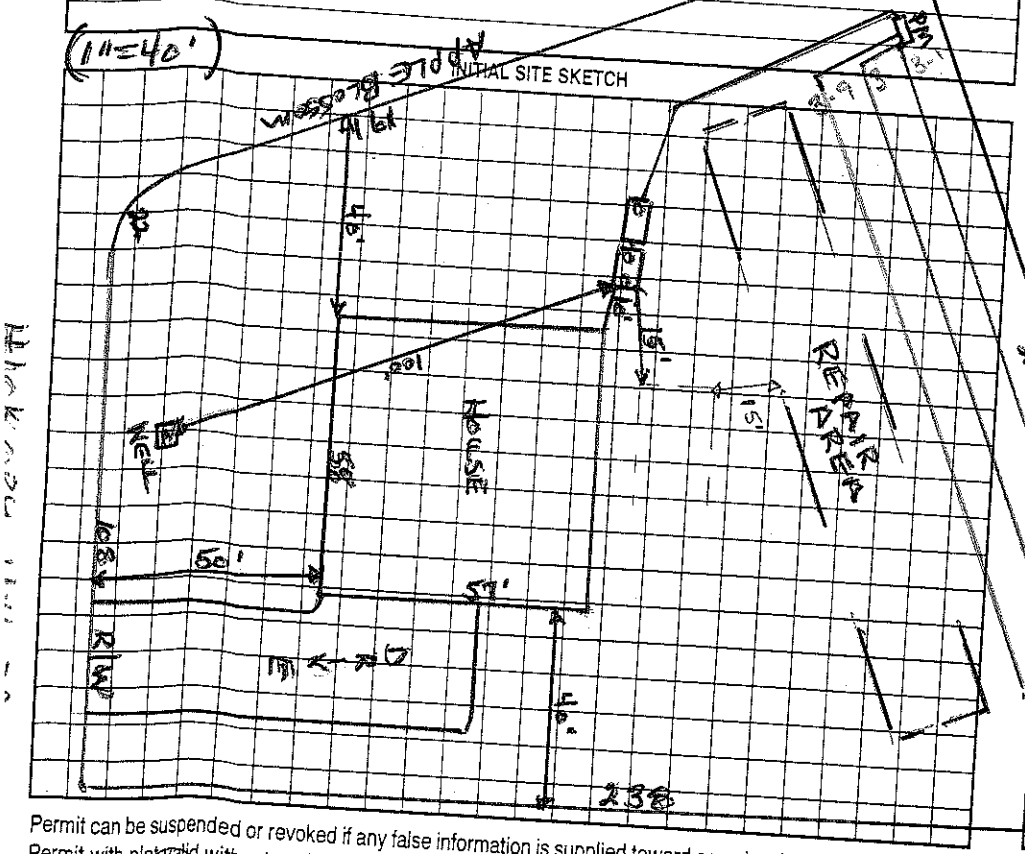

AS BUILT SKETCH

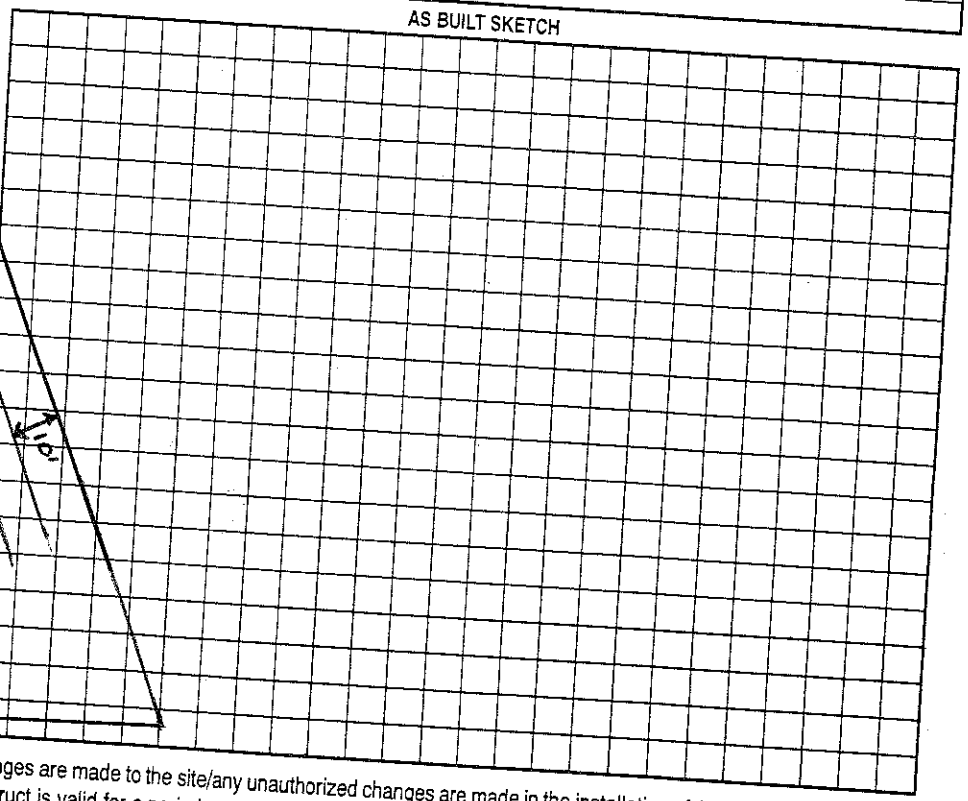

Permit can be suspended or revoked if any false information is supplied toward securing the permit/any unauthorized changes are made to the site/any unauthorized changes are made in the installation of the system. Improvement Permit with plan valid without expiration. Improvement Permit with site plan valid for sixty months. Authorization to Construct is valid for a period equal to that of Improvement Permit – not to exceed sixty months.

Signed:

Improvement Permit by: Wesley Sparks RS. date 3-25-04

Authorization to Construct by: Wesley Sparks RS. date 3/18/04

Installed by: Joe Perkins

Operation Permit by: Wesley Sparks RS date 11/15/04

Existing System Inspection by: date

HEALTH DEPT. COPY: WHITE OWNER COPY (FINAL): YELLOW OWNER COPY (INITIAL): PINK