IREDELL COUNTY HEALTH DEPARTMENT

STATESVILLE 704-878-5305 MOORESVILLE 704-664-5281

IMPROVEMENT PERMIT / AUTHORIZATION TO CONSTRUCT / OPERATION PERMIT / EXISTING SYSTEM INSPECTION

PERMIT# 120971 PIN# 4646 78 3929 2999 DATE 6/14/04

OWNER OR CONTRACTOR Debbs Family Partnership/Rowland Development PHONE: Business 704-364-5171 Home

ADDRESS 3212 Sheron Rd. Charlotte NC. 28211

LOCATION 1100 TL Debbs Rd. TR Apple Blossom on (R) 2 lots before Hickory Hill

SUBDIVISION Debbs Cove BLOCK / SECTION 2 LOT 35 LOT AREA .83 SITE CLASS. RS DESIGN FLOW 360 L.T.A.R. .3

Septic Tank: 1000 Gallons; STB 5-5 Date 11/15/05
Pump Tank: Gallons; PT Date
Pump Make: Model Serial No.
Nitrification Field: No Fields 1 Square Feet 900 Linear Feet 300
No Lines 3@100' Trench Width 3 Max Trench Bottom Depth 30" Gravel Depth

☒ New System ☐ Repair System Type: I, II, (III), IV, V, VI
System Description: Conv. Ref - Type 3
Repair System Description: Pressure - 16" PBIBPS
Maintenance Agreement Required: ☐ Yes ☒ No


☒ House/Mod. Home No. Bedrooms 3
☐ Mobile Home No. Bathrooms 3
☐ Business No. Employees
☐ Other
☐ Slab ☒ Crawl Space ☐ Basement w/plumbing ☐ Basement wo/plumbing

Water Supply: ☒ Individual ☐ Public ☐ Community

Comments:/Conditions: This is a 25% Reduction System

Comments:/Conditions:

INITIAL SITE SKETCH

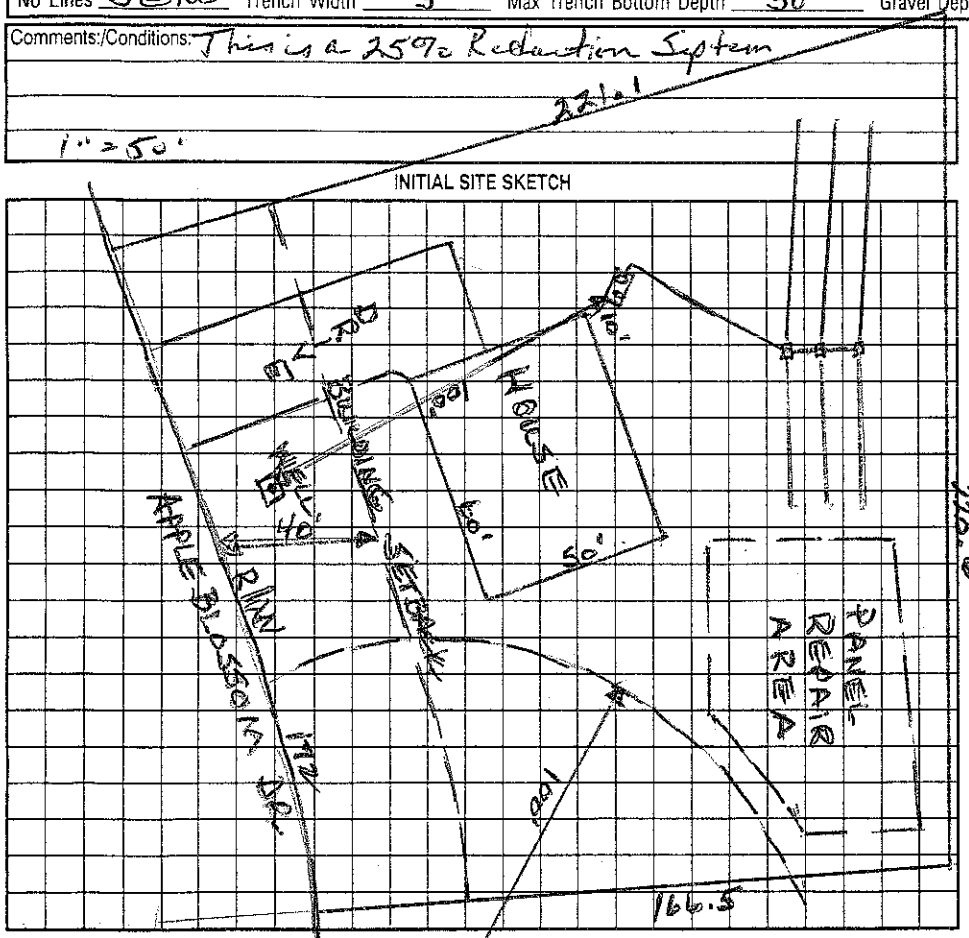

AS BUILT SKETCH

Quick Up Installed

Permit can be suspended or revoked if any false information is supplied toward securing the permit/any unauthorized changes are made to the site/any unauthorized changes are made in the installation of the system. Improvement Permit with plat valid without expiration. Improvement Permit with site plan valid for sixty months. Authorization to Construct is valid for a period equal to that of Improvement Permit – not to exceed sixty months.

Signed: [signature] date 4/8/04 Installed by: Rowan Septic

Improvement Permit by: [signature] RS. date 6/14/04 Operation Permit by: [signature] RS date 4/5/05

Authorization to Construct by: [signature] RS date 10/28/04 Existing System Inspection by: date

HEALTH DEPT. COPY: WHITE OWNER COPY (FINAL): YELLOW OWNER COPY (INITIAL): PINK