IREDELL COUNTY HEALTH DEPARTMENT

STATESVILLE 704-878-5305 MOORESVILLE 704-664-5281

IMPROVEMENT PERMIT / AUTHORIZATION TO CONSTRUCT / OPERATION PERMIT / EXISTING SYSTEM INSPECTION

PERMIT# 5818 PIN# 4646 78 4128 DATE 10/20/98

OWNER OR CONTRACTOR Karen Ray PHONE: Business 663-6015 Home

ADDRESS 104 Onslow Ct. Mooresville NC. 28115

LOCATION Gibbs Road, Brawley Sch. Tr. Gibbs Rd. straight to 5th lot on (R) after Apple Blossom Dr.

SUBDIVISION Gibbs Cove BLOCK / SECTION LOT 59 LOT AREA .68 AC SITE CLASS. P5 DESIGN FLOW 480 L.T.A.R. .3

Septic Tank: Gallons; STB 794 Date 11/3/99
Pump Tank: Gallons; PT Date
Pump Make: Model Serial No.
Nitrification Field: No Fields 1 Square Feet 1200* Linear Feet 400 *
No Lines 4 Trench Width 36" Max Trench Bottom Depth 30" Gravel Depth SAND.

[X] New System [ ] Repair System Type: I, II, (III), IV, V, VI
System Description: Gravity - Ch. Plastic
Repair System Description: None
Maintenance Agreement Required: [ ] Yes [X] No

[X] House/Mod. Home No. Bedrooms 4
[ ] Mobile Home No. Bathrooms 3
[ ] Business No. Employees
[ ] Other


[ ] Slab [X] Crawl Space [ ] Basement w/plumbing [ ] Basement wo/plumbing

Water Supply: [X] Individual [ ] Public [ ] Community


Comments:/Conditions: *25% reduction for Ch. Plastic use given. Drain Lines on contour - Watch trench depth.

Comments:/Conditions:

INITIAL SITE SKETCH

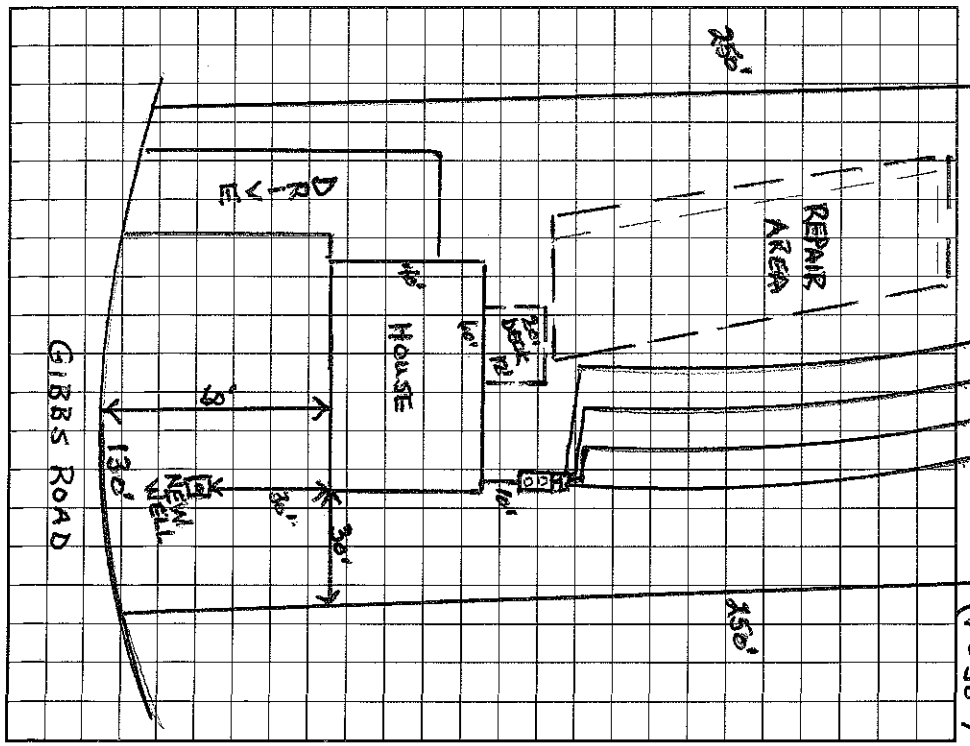

AS BUILT SKETCH

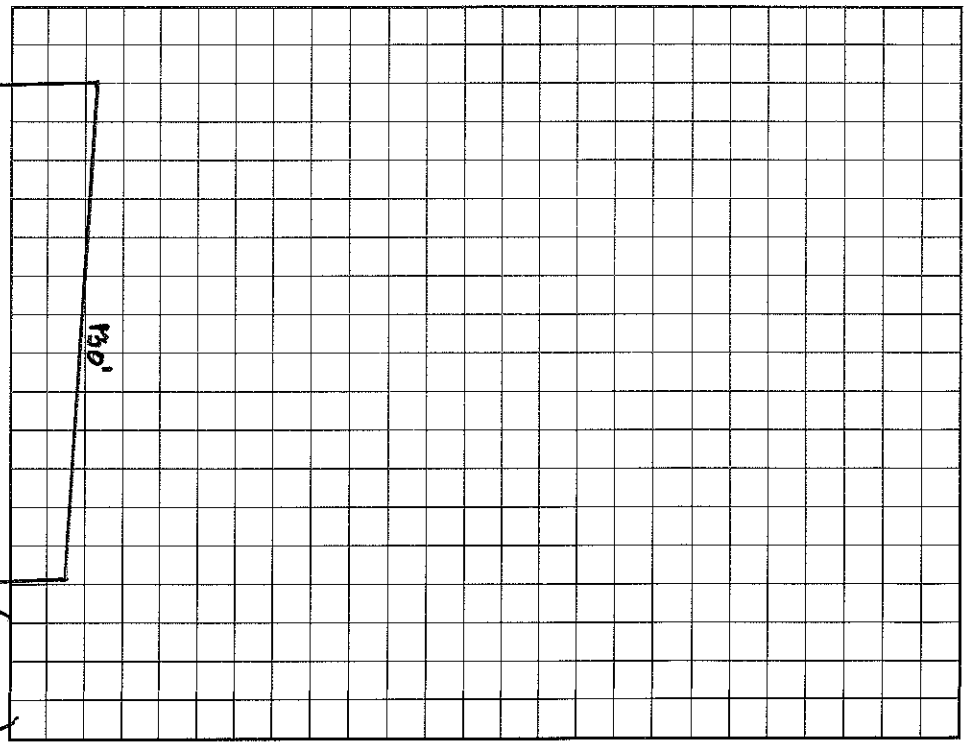

I understand that this permit can be suspended or revoked if any false information is supplied toward securing the permit/any unauthorized changes are made to the site/any unauthorized changes are made in the installation of the system. Improvement Permit with plat valid without expiration. Improvement Permit with site plan valid for sixty months. Authorization to Construct is valid for a period equal to that of Improvement Permit – not to exceed sixty months.

Signed: *Karen B. Ray date 1-19-99 Installed by: Larry Beam

Improvement Permit by: Wesley Sparks RS. date 10/20/98 Operation Permit by: Wesley Sparks RS. date 2/22/00

Authorization to Construct by: Wesley Sparks RS. date 10/26/98 Existing System Inspection by: date

HEALTH DEPT. COPY: WHITE INSPECTION COPY (FINAL): GREEN OWNER COPY (FINAL): YELLOW INSPECTION COPY (INITIAL): PINK OWNER COPY (INITIAL): GOLD