IREDELL COUNTY HEALTH DEPARTMENT

STATESVILLE 704-878-5305 MOORESVILLE 704-664-5281

IMPROVEMENT PERMIT / AUTHORIZATION TO CONSTRUCT / OPERATION PERMIT / EXISTING SYSTEM INSPECTION

PERMIT# 5817 PIN# 4646 78 4279

OWNER OR CONTRACTOR Michael D Clark

ADDRESS PO Box 314 Mooresville, NC. 28115 PHONE: Business 875-1252 EXT 10 Home

DATE 5/12/99

LOCATION Branch of 215 To Dibbs Rd, thru entrance, 4th lot on (R) after Apple Blossom Ct.

SUBDIVISION Dibbs Cove BLOCK / SECTION LOT 40 LOT AREA .68AC SITE CLASS. IS DESIGN FLOW ~~360~~ 360 AWS L.T.A.R. .3

Septic Tank: 1000 Gallons; STB 754 Date 4/12/99

Pump Tank: Gallons; PT Date

Pump Make: Model Serial No.

Nitrification Field: No Fields 1 Square Feet 1200 Linear Feet 400

No Lines 4 Trench Width 36" Max Trench Bottom Depth 32" Gravel Depth SAND.

☒ New System ☐ Repair System Type: I II III IV, V, VI

System Description: Gravity - CHAMBERS OR HDS

Repair System Description: Pressure - Panel

Maintenance Agreement Required: ☐ Yes ☒ No

☒ House/Mod. Home ☐ Mobile Home ☐ Business ☐ Other

No. Bedrooms 3 No. Bathrooms 3 No. Employees

☐ Slab ☒ Crawl Space ☐ Basement w/plumbing ☐ Basement wo/plumbing

Water Supply: ☒ Individual ☐ Public ☐ Community


Comments:/Conditions: ST located as drawn to avoid need to pump - deep plumbing - shallow This voids Auth Const. dated 10/15/98

Comments:/Conditions:


10/1/99 - Authorized use of 400 feet of Conventional Drainfield. AWS.

(1"=50')

INITIAL SITE SKETCH

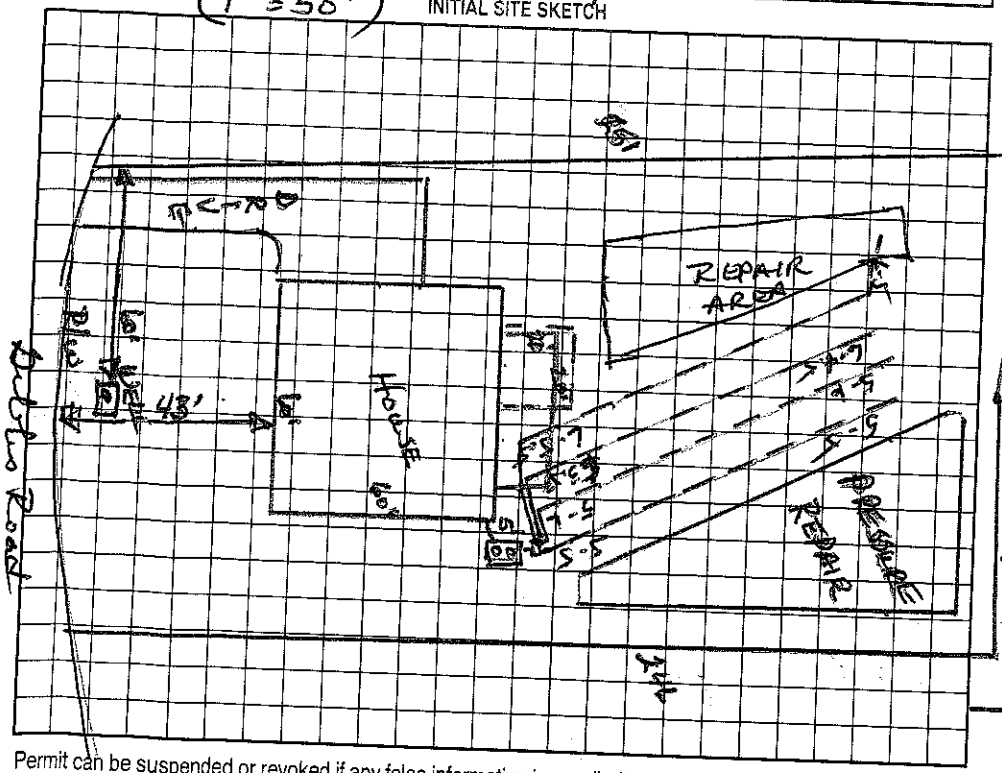

AS BUILT SKETCH

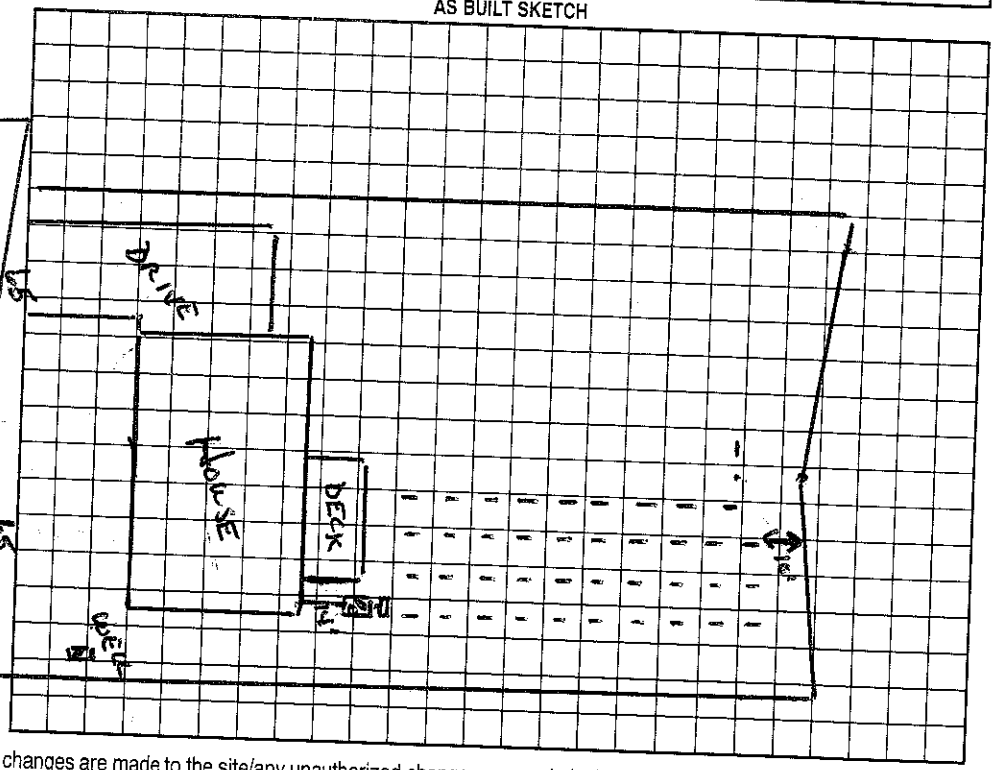

Permit can be suspended or revoked if any false information is supplied toward securing the permit/any unauthorized changes are made to the site/any unauthorized changes are made in the installation of the system. Improvement Permit with plat valid without expiration. Improvement Permit with site plan valid for sixty months. Authorization to Construct is valid for a period equal to that of Improvement Permit – not to exceed sixty months.

Signed: Debra Clark date 5-18-99

Improvement Permit by: Wesley Sparks RS. date 5/12/99

Authorization to Construct by: Wesley Sparks RS. date 5/12/99

Installed by: F.T Ervin

Operation Permit by: Wesley Sparks RS. date 10/5/99

Existing System Inspection by: date

HEALTH DEPT. COPY: WHITE OWNER COPY (FINAL): YELLOW OWNER COPY (INITIAL): PINK