11:00

IREDELL COUNTY HEALTH DEPARTMENT

STATESVILLE 704-878-5305 MOORESVILLE 704-664-5281

IMPROVEMENT PERMIT / AUTHORIZATION TO CONSTRUCT / OPERATION PERMIT / EXISTING SYSTEM INSPECTION

PERMIT# 4061 PIN# 4646 78 4482 DATE 12/16/99

OWNER OR CONTRACTOR Clinton + LeAnn Brown PHONE: Business 483-2342 Home

ADDRESS 7210 Executive Cir. Denver NC. 28037

LOCATION Brawley Sch Rd. TL Dibbs Rd. 3rd on (R) past Apple Blossom Lane

SUBDIVISION Dibbs Cove BLOCK / SECTION LOT 61 LOT AREA .73Ac SITE CLASS. PS DESIGN FLOW 600 L.T.A.R. .3

Septic Tank 1500 ~~1250~~ Gallons; STB 338 Date 7-7-00
Pump Tank: Gallons; PT Date
Pump Make: Model Serial No.
Nitrification Field: No. Fields 1 Square Feet 1350 Linear Feet 450
No Lines 54 Trench Width 36" Max Trench Bottom Depth 30" Gravel Depth SAND.

[X] New System ☐ Repair System Type: I, II, (III) IV, V, VI
System Description: Gravity - Ch. Plastic
Repair System Description: None
Maintenance Agreement Required: ☐ Yes [X] No


[X] House/Mod. Home No. Bedrooms 5
☐ Mobile Home No. Bathrooms 4
☐ Business No. Employees
☐ Other
☐ Slab [X] Crawl Space ☐ Basement w/plumbing ☐ Basement wo/plumbing

Water Supply: [X] Individual ☐ Public ☐ Community

Comments:/Conditions:

Comments:/Conditions: Installed in 4 lines at 115'

INITIAL SITE SKETCH

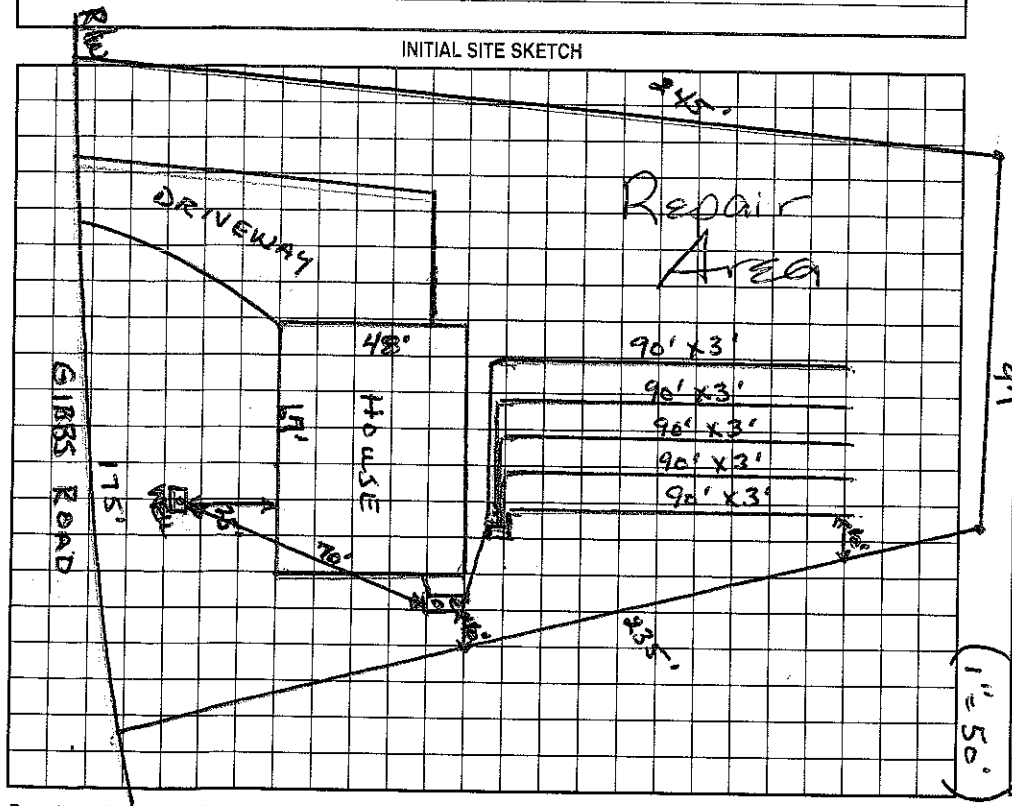

AS BUILT SKETCH

Permit can be suspended or revoked if any false information is supplied toward securing the permit/any unauthorized changes are made to the site/any unauthorized changes are made in the installation of the system. Improvement Permit with plat valid without expiration. Improvement Permit with site plan valid for sixty months. Authorization to Construct is valid for a period equal to that of Improvement Permit – not to exceed sixty months.

Signed: [signature] date 12/20/99

Improvement Permit by: Wesley Sparks R.S. date 12/16/99

Authorization to Construct by: Wesley Sparks R.S. date 12/16/99

Installed by: E.J. Erwin

Operation Permit by: [signature] R.S. date 8/22/2000

Existing System Inspection by: date

HEALTH DEPT. COPY: WHITE OWNER COPY (FINAL): YELLOW OWNER COPY (INITIAL): PINK