4646-78-4576

IREDELL COUNTY HEALTH DEPARTMENT

Auth to Construct

STATESVILLE 704-878-5305 MOORESVILLE 704-664-5281

IMPROVEMENT PERMIT / ~~CERTIFICATE OF COMPLETION~~ / OPERATION PERMIT / EXISTING SYSTEM INSPECTION

PROPERTY DESCRIPTION NO. 3649 DATE Jan. 10, '96 TAX MAP NO. 2J18A62 Watershed: ☑ Yes ☐ No

OWNER OR CONTRACTOR Donald Disharoon PHONE: Business _____ Home _____

ADDRESS 124 Meadow Crk Ln. Mooresville

LOCATION Brawley Sch Rd. x I-77 Th Gibbs Rd on Right

SUBDIVISION Gibbs Cove BLOCK / SECTION _____ LOT 62 LOT AREA ~155'x235' SITE CLASS. PS DESIGN FLOW 480gpd L.T.A.R. .3

Septic Tank: 1000 Gallons; STB _____ Date _____

Pump Tank: _____ Gallons; PT _____ Date _____

Pump Make: _____ Model _____ Serial No. _____

Nitrification Field: No Fields 1 Square Feet 1620 Linear Feet 540

No Lines 3+3 Trench Width 36" Max Trench Bottom Depth 24" Gravel Depth 12"

☑ New System ☐ Repair System Type: I, (II), III, IV, V, VI

System Description: gravity conventional

Repair System Description: grav. INF

Maintenance Agreement Required: ☐ Yes ☑ No

☑ House/Mod. Home No. Bedrooms 4

☐ Mobile Home No. Bathrooms 3

☐ Business No. Employees _____

☐ Other _____


☐ Slab ☑ Crawl Space ☐ Basement w/plumbing ☐ Basement wo/plumbing

Water Supply: ☑ Individual ☐ Community ☐ Public


Comments:

Comments:

INITIAL SITE SKETCH

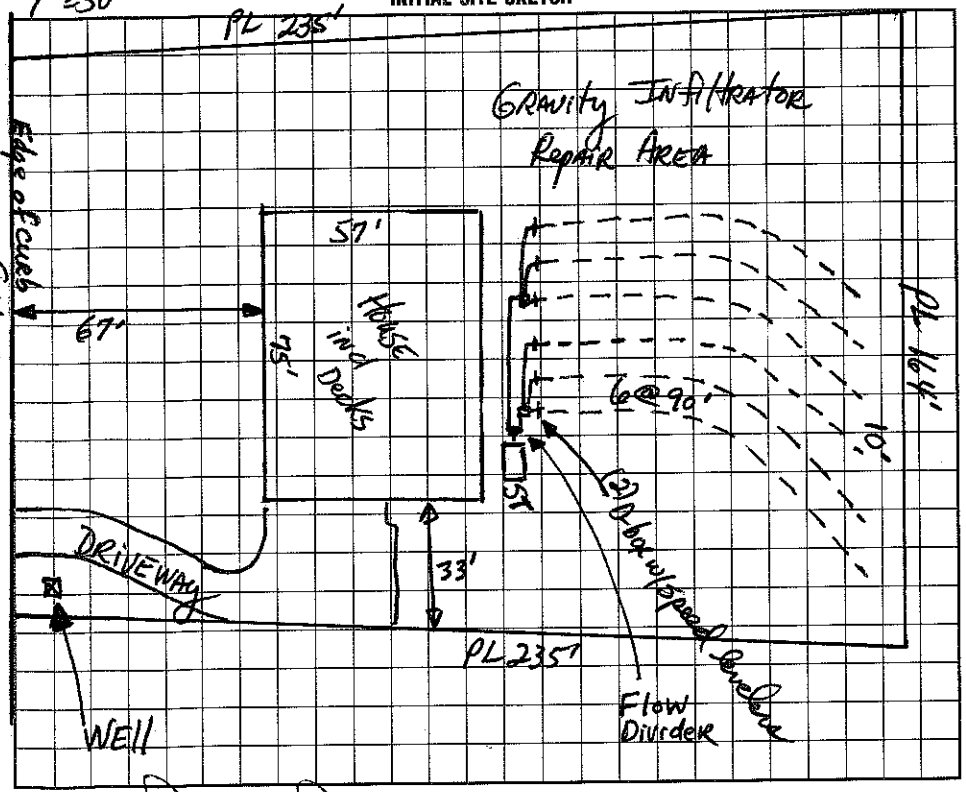

AS BUILT SKETCH

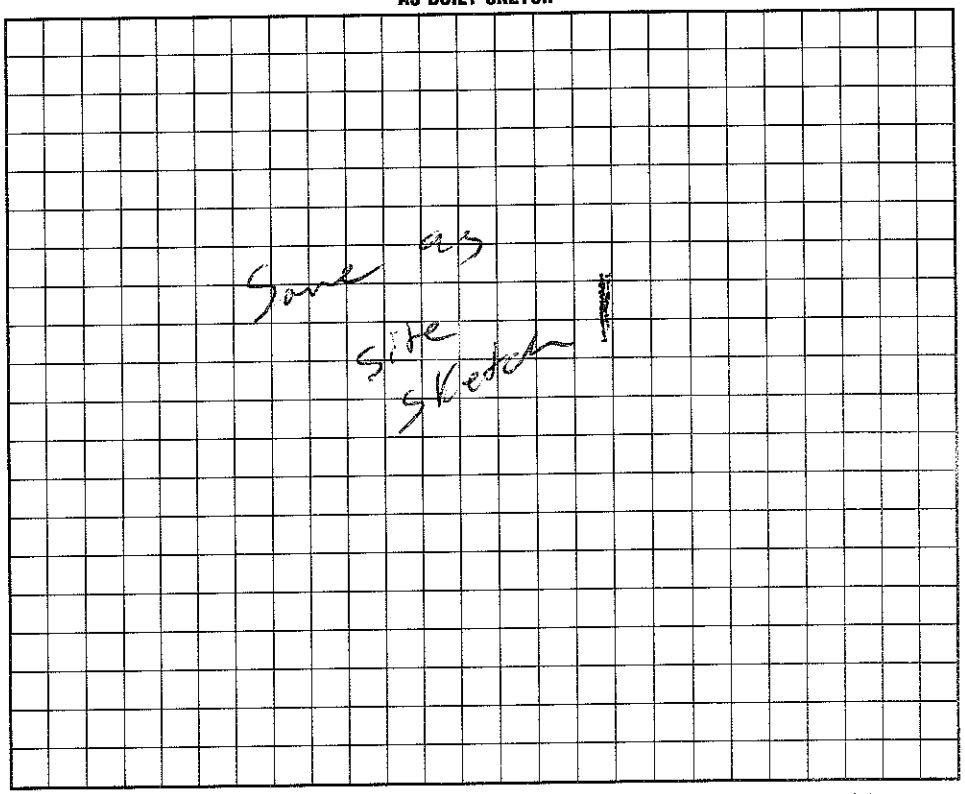

I understand that this permit can be suspended or revoked if any false information is supplied toward securing the permit/any unauthorized changes are made to the site/any unauthorized changes are made in the installation of the system.

Signed: X Donald Disharoon

Improvement Permit by: David R. Hinson RS date 1-10-96

~~Authorization~~ to construct

~~Existing System Inspection~~ by: D.R. Hinson RS date 1-10-96

Installed by: Ironhorse

Certificate of Completion by: _____ date _____

Operation Permit by: C. Buby Thomas date 7/16/96

HEALTH DEPT. COPY: WHITE INSPECTION COPY (FINAL): GREEN OWNER COPY (FINAL): YELLOW INSPECTION COPY (INITIAL): PINK OWNER COPY (INITIAL): GOLD