IREDELL COUNTY HEALTH DEPARTMENT

STATESVILLE 704-878-5305 MOORESVILLE 704-664-528

IMPROVEMENT PERMIT / AUTHORIZATION TO CONSTRUCT / OPERATION PERMIT / EXISTING SYSTEM INSPEC ON

PERMIT# 7082 PIN# 4646 785 738 DATE 3/16/2000

OWNER OR CONTRACTOR Jean Correll/Citadel Homes PHONE: Business 372-0935 ext 130 Home

ADDRESS 1105 North Church St. Charlotte NC 28206

LOCATION Brawley School Rd TL Gibbs Cove at intersection of Gibbs Rd & Apple Blossom

SUBDIVISION Gibbs Cove BLOCK / SECTION LOT 38 LOT AREA .971 Acre SITE CLASS. PS DESIGN FLOW 360gpd L.T.A.R. .3

Septic Tank: 1000 Gallons; STB 312 Date 7-25-00
Pump Tank: Gallons; PT Date
Pump Make: Model Serial No.
Nitrification Field: No Fields 1 Square Feet 900' Linear Feet 300'
No Lines 4 at 75' Trench Width 36" Max Trench Bottom Depth 36"

☒ New System ☐ Repair System Type: I II III IV V VI
System Description: Gravity - 25% Reduction
Repair System Description: Innovative
Maintenance Agreement Required: ☐ Yes ☒ No

☒ House/Mod. Home No. Bedrooms 3
☐ Mobile Home No. Bathrooms 3
☐ Business No. Employees
☐ Other


Gravel Depth N/A ☐ Slab ☒ Crawl Space ☐ Basement w/plumbing ☐ Basement wo/plumbing

Water Supply: ☒ Individual ☐ Public ☐ Community


Comments:/Conditions: Keep Septic System at least 10' from PL & 5' from house & 100' From any well.

Comments:/Conditions: Septic System is Saprolite, Must Maintain 100' setback between well & Septic.

INITIAL SITE SKETCH Scale 1:50'

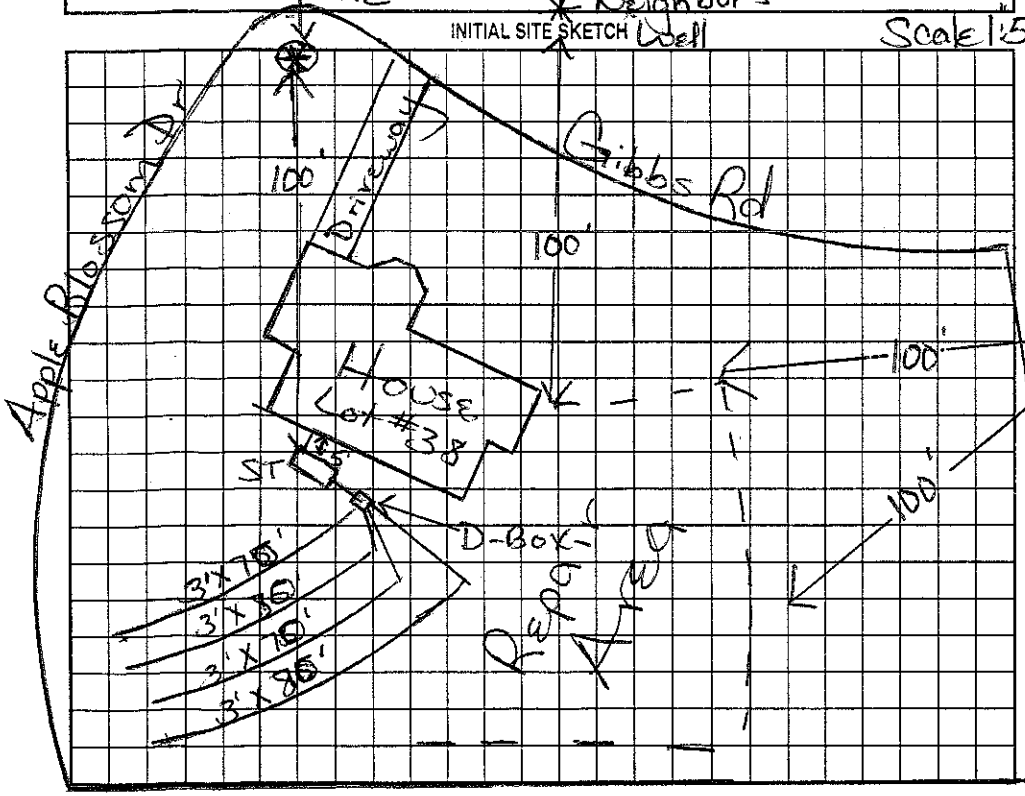

AS BUILT SKETCH

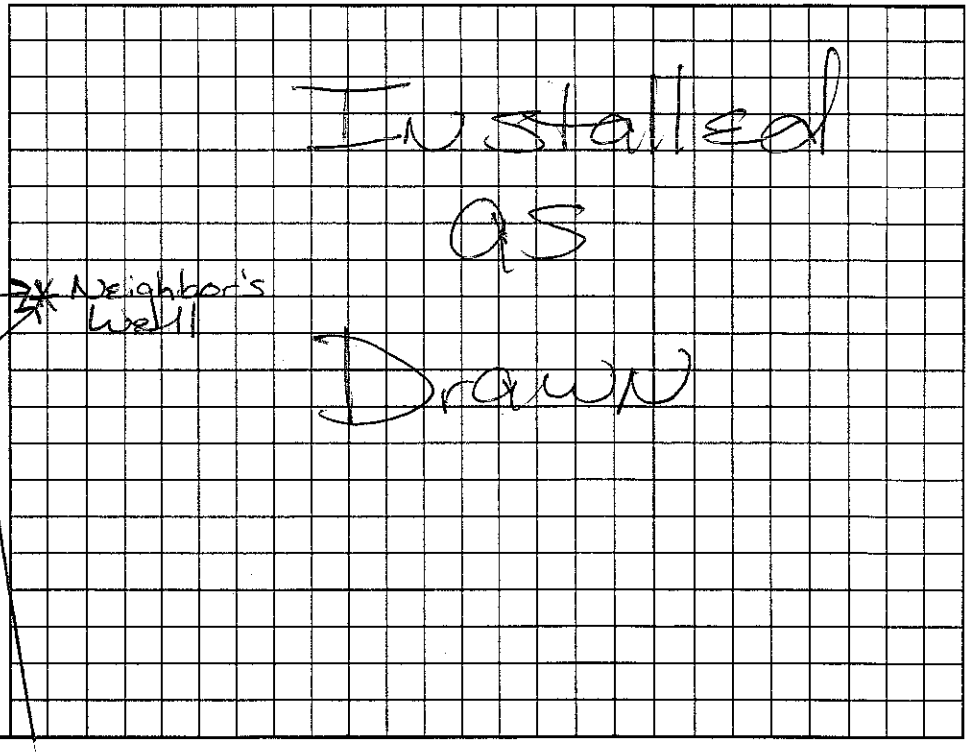

Permit can be suspended or revoked if any false information is supplied toward securing the permit/any unauthorized changes are made to the site/any unauthorized changes are made in the installation of the system. Improvement Permit with plat valid without expiration. Improvement Permit with site plan valid for sixty months. Authorization to Construct is valid for a period equal to that of Improvement Permit – not to exceed sixty months.

Signed: Jean J Correll date 3-24-00 Installed by: Orbison

Improvement Permit by: Maria H Dotson RS date 3/16/2000 Operation Permit by: Maria H Dotson RS date 9/1/00

Authorization to Construct by: Maria H Dotson RS date 3/16/2000 Existing System Inspection by: date

HEALTH DEPT. COPY: WHITE OWNER COPY (FINAL): YELLOW OWNER COPY (INITIAL): PINK