IREDELL COUNTY HEALTH DEPARTMENT

STATESVILLE 704-878-5305 300.00 Paid MOORESVILLE 704-664-5281

IMPROVEMENT PERMIT / AUTHORIZATION TO CONSTRUCT / OPERATION PERMIT / EXISTING SYSTEM INSPECTION

PERMIT# 00105 / 6719 PIN# 4646 78 6050 DATE 2/14/01

OWNER OR CONTRACTOR Carol Ann Neill PHONE: Business 664-4485 Home

ADDRESS PO Box 921 Mooresville, NC. 28115

LOCATION Brawley School Rd TL Gibbs Rd. on (L) eighth lot below sign

SUBDIVISION GIBBS COVE BLOCK / SECTION 1 LOT 8 LOT AREA .775 AC SITE CLASS. PS DESIGN FLOW 360 L.T.A.R. .3

Septic Tank: 1000 Gallons; STB 794 Date 9/8/01
Pump Tank: Gallons; PT Date
Pump Make: Model Serial No.
Nitrification Field: No Fields 1 Square Feet 900 * Linear Feet 300 *
No Lines 3 @ 100' x 3' Trench Width 3' Max Trench Bottom Depth 3'

☑ New System ☐ Repair System Type: I, II, (III), IV, V, VI
System Description: GRAV – HOS or CH. PLAS.
Repair System Description: SAME
Maintenance Agreement Required: ☐ Yes ☐ No
Gravel Depth No
☐ Slab ☐ Crawl Space ☒ Basement w/plumbing ☐ Basement wo/plumbing


☒ House/Mod. Home No. Bedrooms 3
☐ Mobile Home No. Bathrooms 3
☐ Business No. Employees
☐ Other

Water Supply:
☒ Individual
☐ Public
☐ Community


Comments:/Conditions:

Comments:/Conditions:

(1"=50') INITIAL SITE SKETCH

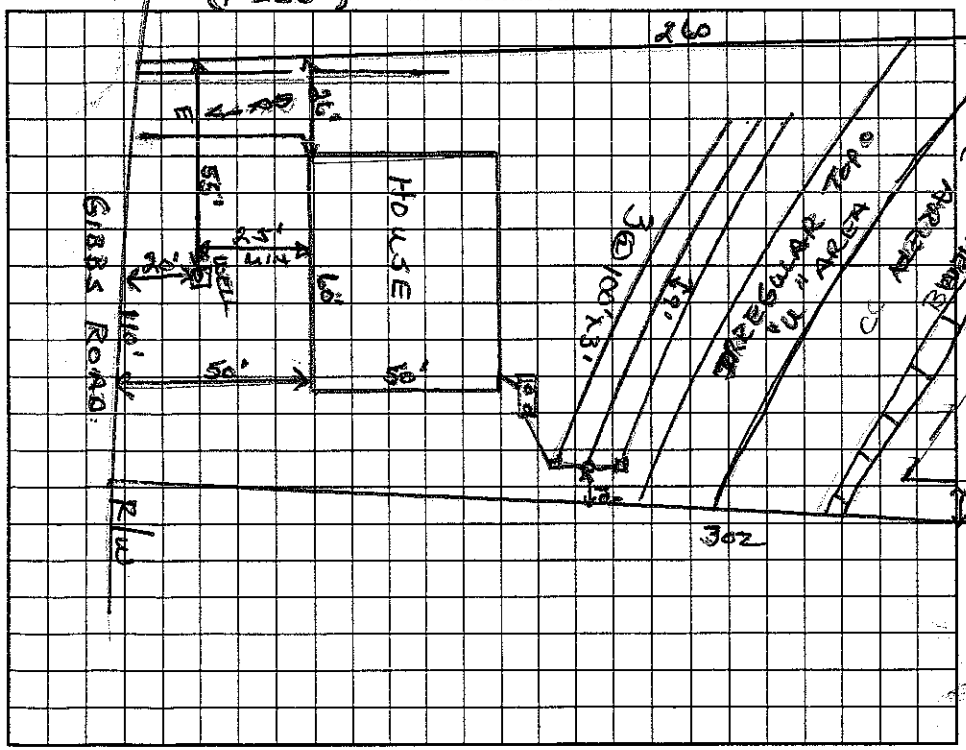

AS BUILT SKETCH

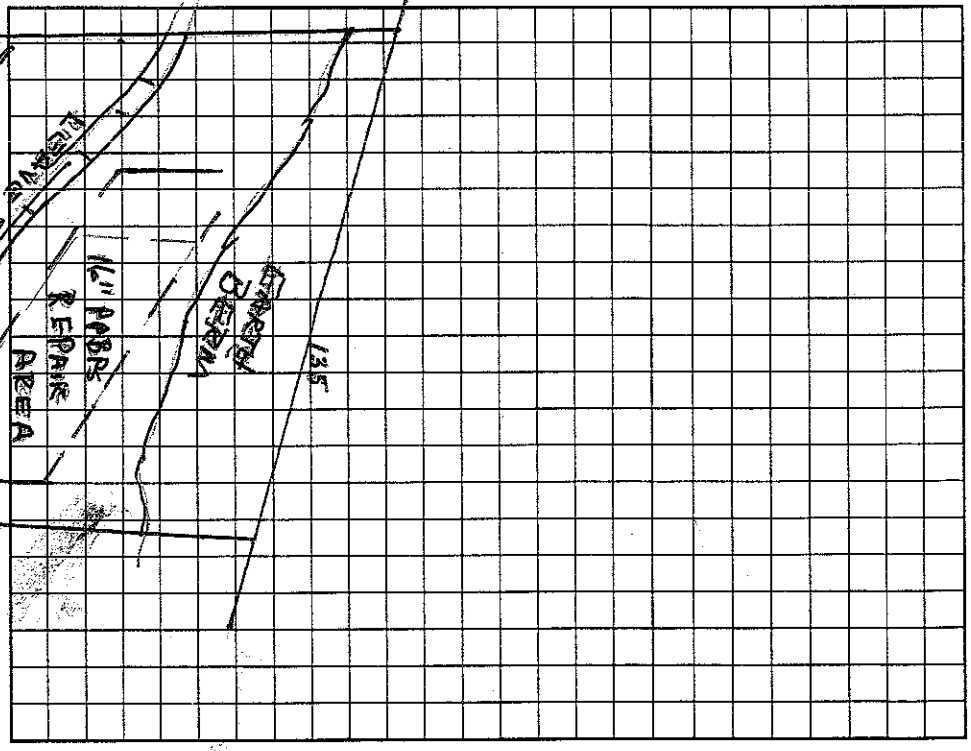

Permit can be suspended or revoked if any false information is supplied toward securing the permit/any unauthorized changes are made to the site/any unauthorized changes are made in the installation of the system. Improvement Permit with plat valid without expiration. Improvement Permit with site plan valid for sixty months. Authorization to Construct is valid for a period equal to that of Improvement Permit – not to exceed sixty months.

Signed: Carol Ann Neill date 3/2/01

Improvement Permit by: Wesley Sparks RS. date 2/14/01

Authorization to Construct by: Wesley Sparks RS date 2/14/01

Installed by: F J Ervin

Operation Permit by: Wesley Sparks RS date 10/26/01

Existing System Inspection by: date

HEALTH DEPT. COPY: WHITE OWNER COPY (FINAL): YELLOW OWNER COPY (INITIAL): PINK