IREDELL COUNTY HEALTH DEPARTMENT

Paid 300.00 DT 11:00

STATESVILLE 704-878-5305 MOORESVILLE 704-664-5281

IMPROVEMENT PERMIT / AUTHORIZATION TO CONSTRUCT / OPERATION PERMIT / EXISTING SYSTEM INSPECTION

PERMIT# 8274 PIN# 4646787358 DATE 12-6-2000

OWNER OR CONTRACTOR Lushorn & Leonard Millsaps PHONE: Business Cell 617-7008 Home 563-1573

ADDRESS 2507-16 Cross Pt. Cir Matthews, NC 28105

LOCATION Brawley School Rd TL Gibbs Rd go past Apple Blossom on left across from "Blue house"

SUBDIVISION Gibbs Cove BLOCK / SECTION ____ LOT 5 LOT AREA 1.01 Acre SITE CLASS. RS DESIGN FLOW 480 gpd L.T.A.R. .3

Septic Tank: 1000 Gallons; STB 794 Date 1-8-01

Pump Tank: ____ Gallons; PT ____ Date ____

Pump Make: ____ Model ____ Serial No. ____

Nitrification Field: No Fields 1 Square Feet 1200' Linear Feet 400'

No Lines 3 at 133' Trench Width 36" Max Trench Bottom Depth 36" Gravel Depth N/A

☐ New System ☐ Repair System Type: I, II, III, IV, V, VI

System Description: Gravity -25% Reduction

Repair System Description: Pump to Innovative

Maintenance Agreement Required: ☐ Yes ☒ No

☒ House/Mod. Home ☐ Mobile Home ☐ Business ☐ Other

No. Bedrooms 4 No. Bathrooms 3.5 No. Employees ____


☐ Slab ☒ Crawl Space ☐ Basement w/plumbing ☐ Basement wo/plumbing

Water Supply: ☒ Individual ☐ Public ☐ Community

Comments:/Conditions: PL 251.43'


Comments:/Conditions: Keep Septic System at least 10' from PL, 5' from house & 50' from any well. Any future pool must be at least 15' from septic system. Grey Fr Hse installed.

INITIAL SITE SKETCH

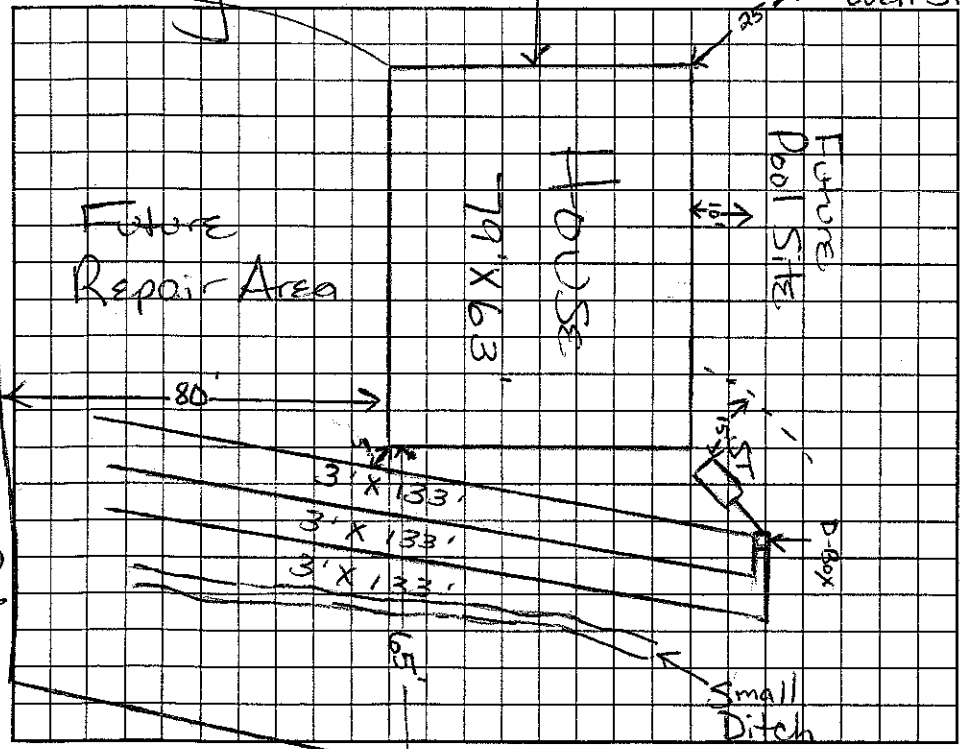

AS BUILT SKETCH

Scale 1:40'

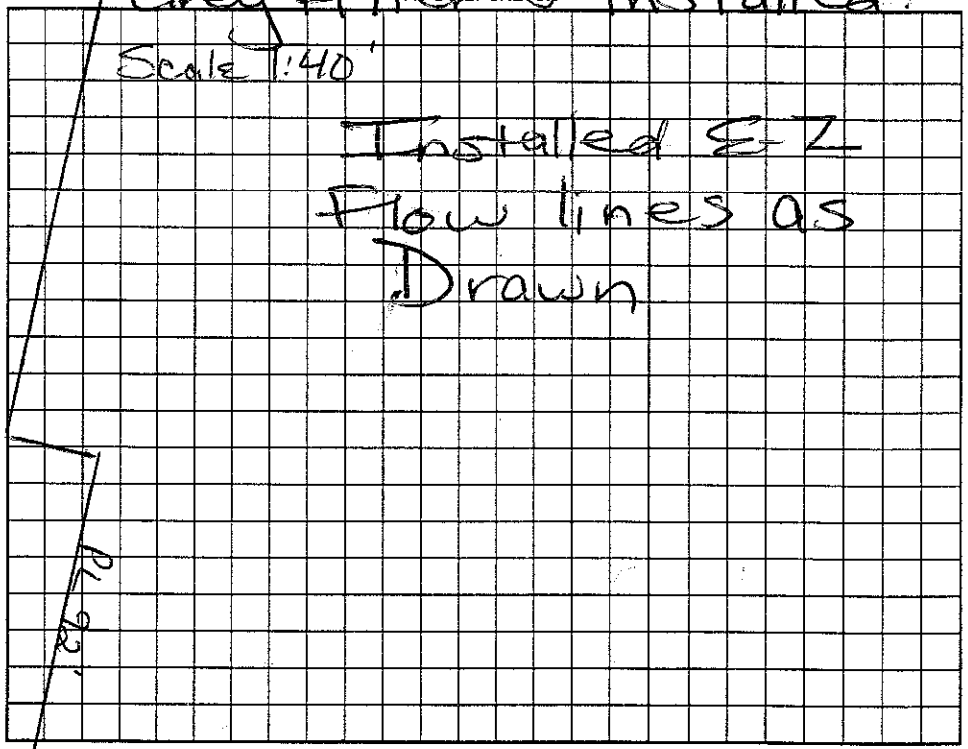

Permit can be suspended or revoked if any false information is supplied toward securing the permit/any unauthorized changes are made to the site/any unauthorized changes are made in the installation of the system. Improvement Permit with plat valid without expiration. Improvement Permit with site plan valid for sixty months. Authorization to Construct is valid for a period equal to that of Improvement Permit – not to exceed sixty months.

Signed: Lushorn Millsaps date 12-8-00 Installed by: R & H Inc

Improvement Permit by: Maria H.H. Dotson R.S. date 12/6/2000 Operation Permit by: Maria H.H. Dotson RS date 9/11/2001

Authorization to Construct by: Maria H.H. Dotson RS date 12/6/2000 Existing System Inspection by: ____ date ____

HEALTH DEPT. COPY: WHITE OWNER COPY (FINAL): YELLOW OWNER COPY (INITIAL): PINK