IREDELL COUNTY HEALTH DEPARTMENT

STATESVILLE 704-878-5305 MOORESVILLE 704-664-5281

IMPROVEMENT PERMIT / AUTHORIZATION TO CONSTRUCT / OPERATION PERMIT / EXISTING SYSTEM INSPECTION

PERMIT # 157349 PIN # 4646-78-8824 DATE 7-14-09

OWNER or APPLICANT FRED WERMUTH 4646-78-8835 PHONE: Business 704-634-7900 Home: MIKE HELMS

OWNER or APPLICANT ADDRESS 231 GIBBS COVE RD MVILLE

LOCATION / DIRECTIONS BSR, TL GIBBS RD, ON L

SUBDIVISION GIBBS COVE BLOCK / SECTION LOT # 2 LOT AREA .18 AC DESIGN FLOW 480 L.T.A.R. .25

Septic Tank 1000 Gallons: STB 794 Date 8-26-09

Pump Tank Gallons: P T Date

Pump Make Model Serial #

Nitrification Field No Fields 1 No Lines 5 Linear Feet 480'

Trench Width 36" Max. Trench Bottom Depth 24" Gravel Depth

☒ New System ☐ Repair ☐ Expansion System Type I (II) III IV V VI

System Description: GRAVITY 25% REDUCTION

Repair System Description: LP- PANEL

Maintenance Agreement Required ☐ YES ☒ NO INITIALLY

☒ GRAVITY ☐ PRESSURE

☒ Residence No. Bedrooms 4 ☐ Business No. Persons ☐ Other No. Employees


☐ Slab ☒ Crawl Space ☐ Basement w/plumbing ☐ Basement w/o plumbing

Water Supply: ☒ Private ☐ Public ☐ Community


Comments / Conditions

Comments / Conditions: 1) MEET ALL REQUIRED SET BACKS 2) USE 24" TRENCH BOTTOM

INITIAL SITE SKETCH

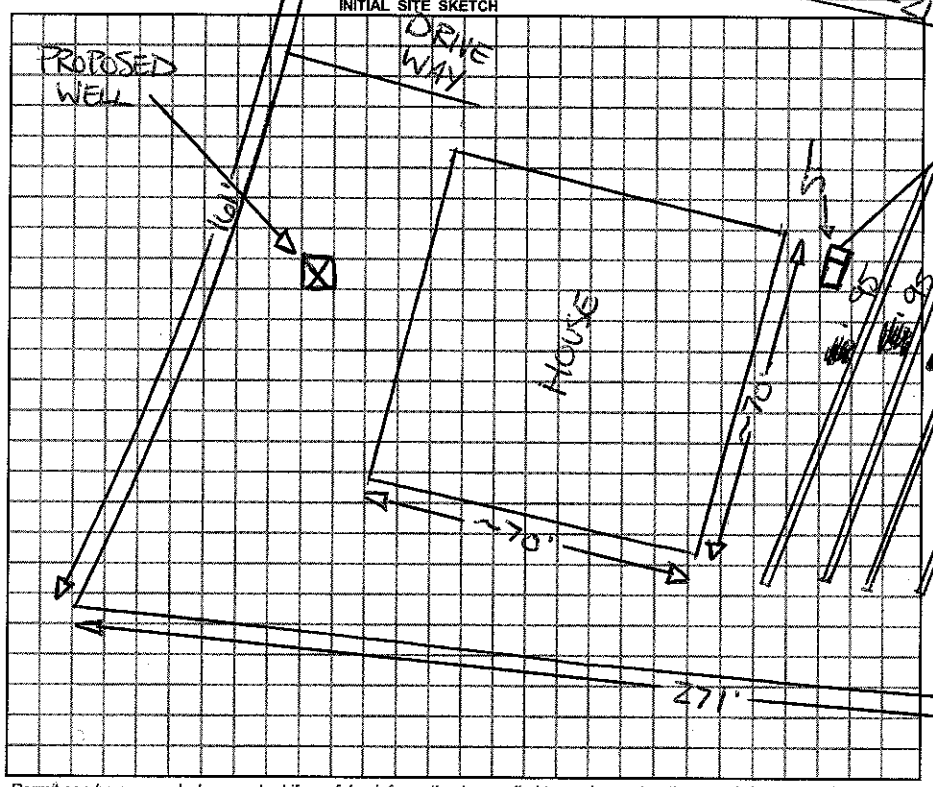

AS BUILT SKETCH 1"=40'

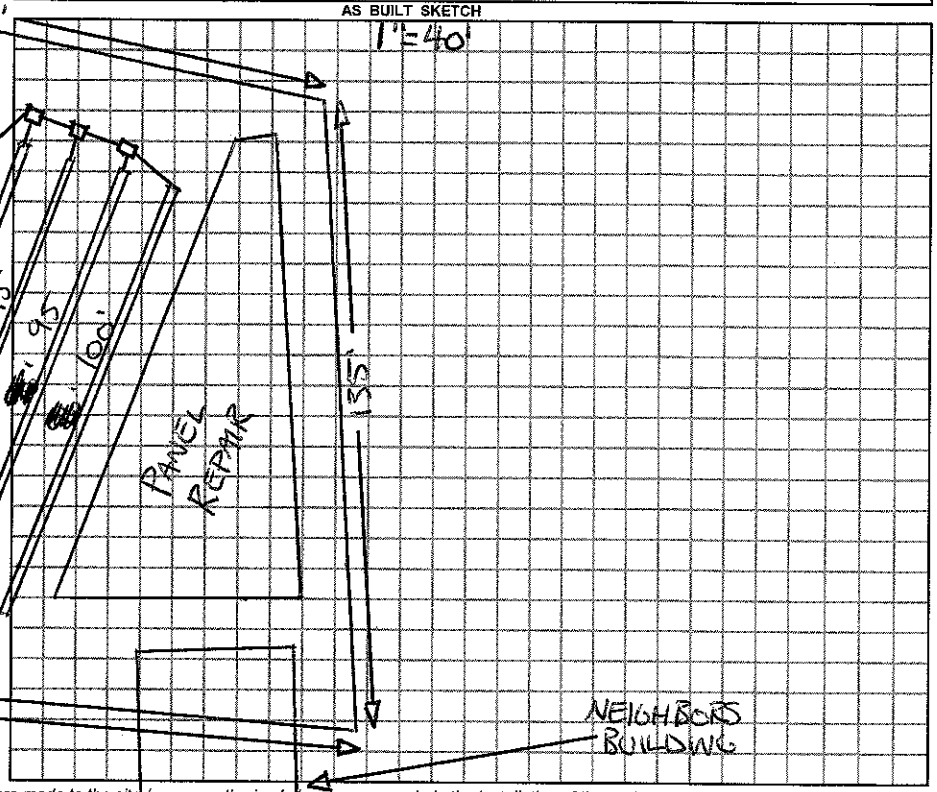

Permit can be suspended or revoked if any false information is supplied toward securing the permit / any unauthorized changes are made to the site / any unauthorized changes are made in the installation of the system.

☐ *IMPROVEMENT PERMIT w / plat valid without expiration* ☒ *IMPROVEMENT PERMIT w / site plan valid for 60 mos.* ☒ *AUTHORIZATION TO CONSTRUCT valid for period equal to IMPROVEMENT PERMIT-not to exceed 60 mo.*

Owner / Applicant Signature: Date 7-15-09

Improvement Permit by: Date 7-14-09

Authorzation to Construct by: Date 7-15-09

YOU SHOULD CONTACT A LOCATOR SERVICE PRIOR TO ANY EXCAVATION.

Installed by: RICHARD ABERNATHY

Operation Permit by: R. Allen, RS. Date: 10-2-09

Existing System Inspected by: Date:

WHITE COPY Environmental Health YELLOW COPY (Final) Owner / Applicant PINK COPY (Initial) Owner / Applicant