IREDELL COUNTY HEALTH DEPARTMENT

STATESVILLE 704-878-5315 | MOORESVILLE 704-664-5281

130.00 Paid

IMPROVEMENT PERMIT / AUTHORIZATION TO CONSTRUCT / OPERATION PERMIT / EXISTING SYSTEM INSPECTION

PERMIT# 19316 PIN# 4646 78 9933 DATE 3/26/04

OWNER OR CONTRACTOR Wild Wind Home Builders PHONE: Business 704-604-5722 Home

ADDRESS 520 Bird Lipati, Cleveland, NC. 27013

LOCATION Apple Blossom Dr. - 1100 TL Gilbert Rd TR Apple Blossom on (R) before Hickory Hill Circle

SUBDIVISION Gilbert Cove BLOCK / SECTION LOT 34 LOT AREA .89 SITE CLASS. PS DESIGN FLOW 480 L.T.A.R. .3

Septic Tank: 1000 Gallons; STB 825 Date 6/20/04
Pump Tank: Gallons; PT Date
Pump Make: Model Serial No.
Nitrification Field: No Fields 1 Square Feet 1200 Linear Feet 400
No Lines 4@100 Trench Width 3' Max Trench Bottom Depth 3' Gravel Depth N/A

[X] New System [ ] Repair System Type: I, II, III, IV, V, VI
System Description: Center Feed - 25% Reduced
Repair System Description: Same Type
Maintenance Agreement Required: [ ] Yes [X] No

[X] House/Mod. Home No. Bedrooms 4
[ ] Mobile Home No. Bathrooms 2.5
[ ] Business No. Employees
[ ] Other


Water Supply: [X] Individual [ ] Public [ ] Community

[ ] Slab [X] Crawl Space [ ] Basement w/plumbing [ ] Basement wo/plumbing

Comments:/Conditions: Contours will need to be established by installer, this lot will be graded to flat moved. Recommend EZ Flow since contours do lend somewhat XFP ONLY MUST HAVE HOUSE PLANS BEFORE AC MAY BE ISSUED.

Comments:/Conditions:

INITIAL SITE SKETCH (1" = 50')

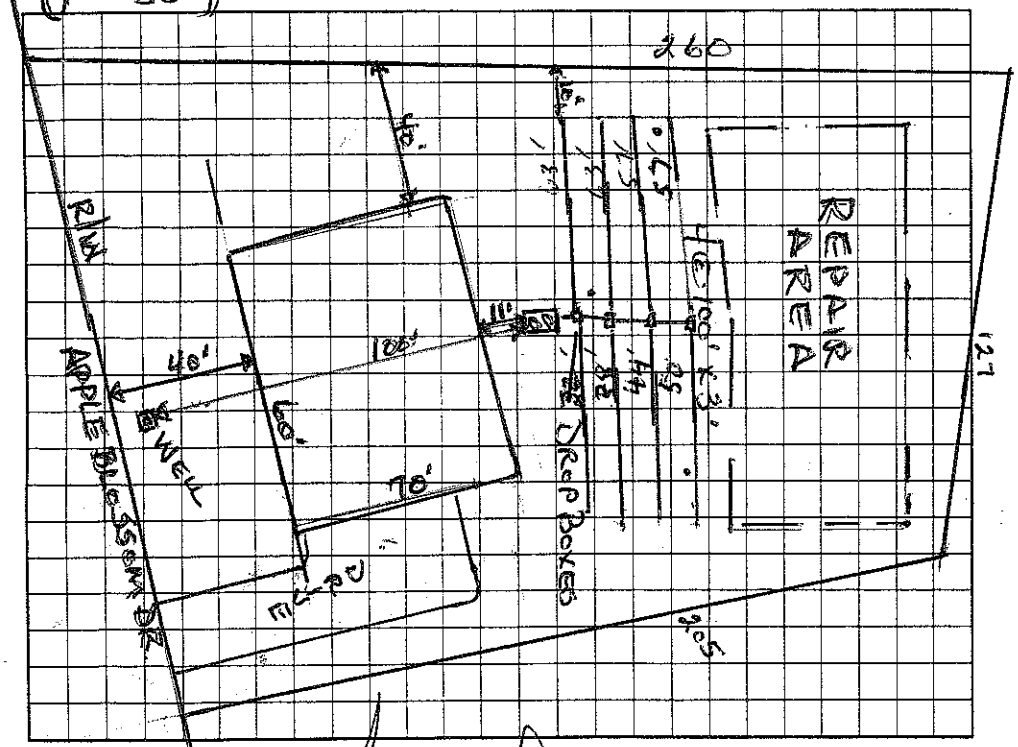

AS BUILT SKETCH

In Ft Heaters Installed

Permit can be suspended or revoked if any false information is supplied toward securing the permit/any unauthorized changes are made to the site/any unauthorized changes are made in the installation of the system. Improvement Permit with plat valid without expiration. Improvement Permit with site plan valid for sixty months. Authorization to Construct is valid for a period equal to that of Improvement Permit – not to exceed sixty months.

Signed: Michael V. Dalpiaz date 3/30/04 Installed by: Rowan Septic

Improvement Permit by: Wesley Sparks RS. date 3/26/04 Operation Permit by: RS date 8/26/04

Authorization to Construct by: Wesley Sparks RS date 4/14/04 Existing System Inspection by: date

HEALTH DEPT. COPY: WHITE OWNER COPY (FINAL): YELLOW OWNER COPY (INITIAL): PINK