IREDELL COUNTY HEALTH DEPARTMENT

STATESVILLE 704-878-5305 50.00 MOORESVILLE 704-664-5281

IMPROVEMENT PERMIT / AUTHORIZATION TO CONSTRUCT / OPERATION PERMIT / EXISTING SYSTEM INSPECTION

PERMIT# ~~5115~~ (89856) PIN# 2J 18 A 36 4646-79-5120 DATE 5/16/00

OWNER OR CONTRACTOR Angela Julian PHONE: Business 309-1268 Home

ADDRESS c/o 1240A River Hwy Mooresville, NC. 28117

LOCATION Dobbs Rd. TR Apple Blossom Ln. to 2ND on (R)

SUBDIVISION Dobbs Cove BLOCK / SECTION 1 LOT 36 LOT AREA .91 AC SITE CLASS. PS DESIGN FLOW 360 L.T.A.R. .3

Septic Tank: 1000 Gallons; STB 312 Date 8/5/00
Pump Tank: Gallons; PT Date
Pump Make: Model Serial No.
Nitrification Field: No. Fields 1 Square Feet 1200 Linear Feet 400
No. Lines ~~50 @ 43'~~ Trench Width 36" Max Trench Bottom Depth 36" Gravel Depth 12"

[X] New System [ ] Repair System Type: I (II) III, IV, V, VI
System Description: GRAVITY - CONVENTIONAL
Repair System Description: SAME
Maintenance Agreement Required: [ ] Yes [X] No


[X] House/Mod. Home No. Bedrooms 3
[ ] Mobile Home No. Bathrooms 3
[ ] Business No. Employees
[ ] Other
[ ] Slab [X] Crawl Space [ ] Basement w/plumbing [ ] Basement wo/plumbing

Water Supply: [X] Individual [ ] Public [ ] Community

Comments/Conditions: (5)

Comments/Conditions:

INITIAL SITE SKETCH (1"=50')

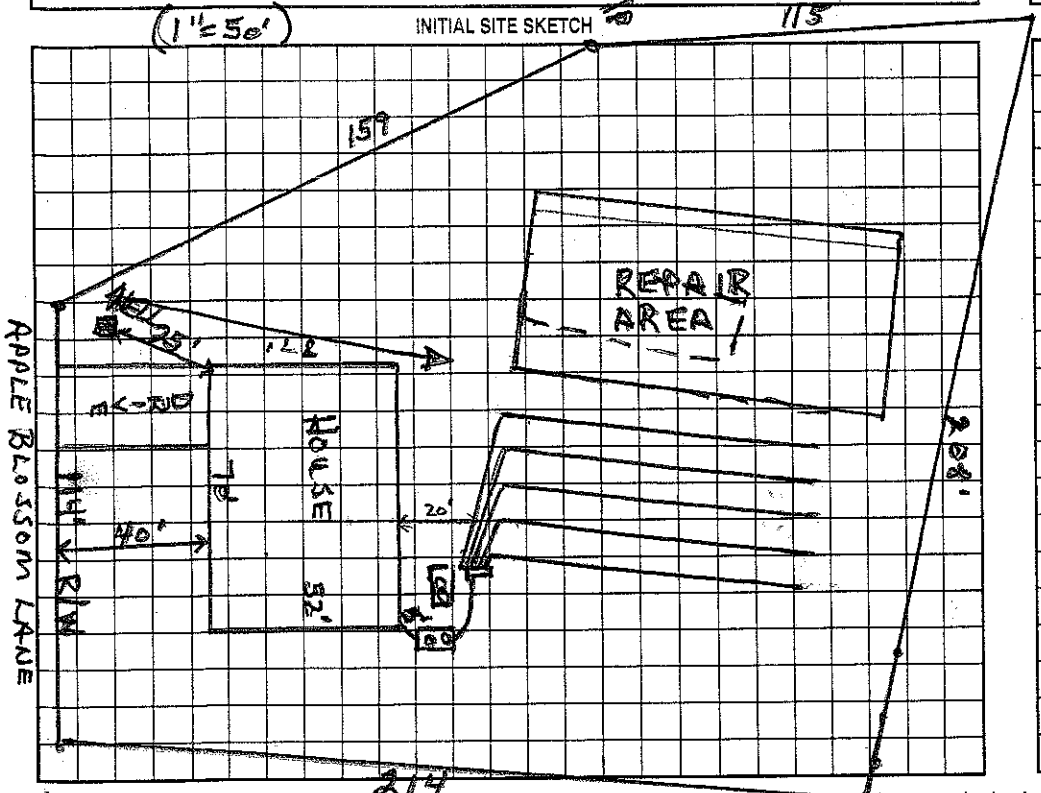

AS BUILT SKETCH

Permit can be suspended or revoked if any false information is supplied toward securing the permit/any unauthorized changes are made to the site/any unauthorized changes are made in the installation of the system. Improvement Permit with plat valid without expiration. Improvement Permit with site plan valid for sixty months. Authorization to Construct is valid for a period equal to that of Improvement Permit – not to exceed sixty months.

Signed: * Joe Wellman date 5/16/00 Installed by: Kevin Hellman

Improvement Permit by: Wesley Sparks RS. date 5/16/00 Operation Permit by: Wesley Sparks RS. date 9/13/00

Authorization to Construct by: Wesley Sparks RS. date 5/16/00 Existing System Inspection by: date

HEALTH DEPT. COPY: WHITE OWNER COPY (FINAL): YELLOW OWNER COPY (INITIAL): PINK