# IREDELL COUNTY HEALTH DEPARTMENT

STATESVILLE 704-878-5305 130.00 Paid MOORESVILLE 704-664-5281

## IMPROVEMENT PERMIT / AUTHORIZATION TO CONSTRUCT / OPERATION PERMIT / EXISTING SYSTEM INSPECTI

PERMIT# 22058-110117 PIN# 4646796073 DATE 6/11/03

OWNER OR CONTRACTOR Tina Kruger PHONE: Business Home 664-3683

ADDRESS 1314 Brawley School Rd (TL Gibbs Rd on left just past Gibbs Cove sign at Apple Blossom)

LOCATION Brawley School Rd

SUBDIVISION Gibbs Cove BLOCK / SECTION LOT 37 LOT AREA .87 Acre SITE CLASS. PS DESIGN FLOW 360gpd L.T.A.R. .3

Septic Tank: 1000 Gallons; STB 312 Date 6-24-03
Pump Tank: Gallons; PT Date
Pump Make: Model Serial No.
Nitrification Field: No Fields 1 Square Feet 900' Linear Feet 300'
No Lines 3 Trench Width 36" Max Trench Bottom Depth 24"-30" Gravel Depth N/A

☒ New System ☐ Repair System Type: I, II, III, IV, V, VI
System Description: Gravity - 25% Reduction
Repair System Description: Pump - Panel Block
Maintenance Agreement Required: ☐ Yes ☐ No

☒ House/Mod. Home No. Bedrooms 3
☐ Mobile Home No. Bathrooms 2
☐ Business No. Employees
☐ Other
☐ Slab ☐ Crawl Space ☐ Basement w/plumbing ☐ Basement wo/plumbing


Water Supply: ☒ Individual ☐ Public ☐ Community

Comments/Conditions: Keep Septic System at least 10' from PL 10' from bottom of berm & 100' Feet to any well

Comments/Conditions: Note: Well installed Closer to Drainfield then Shown in original permit of 11-12-2002, Therefore Drainfield had to be Changed to 25% reduction.

INITIAL SITE SKETCH

Scale 1:50

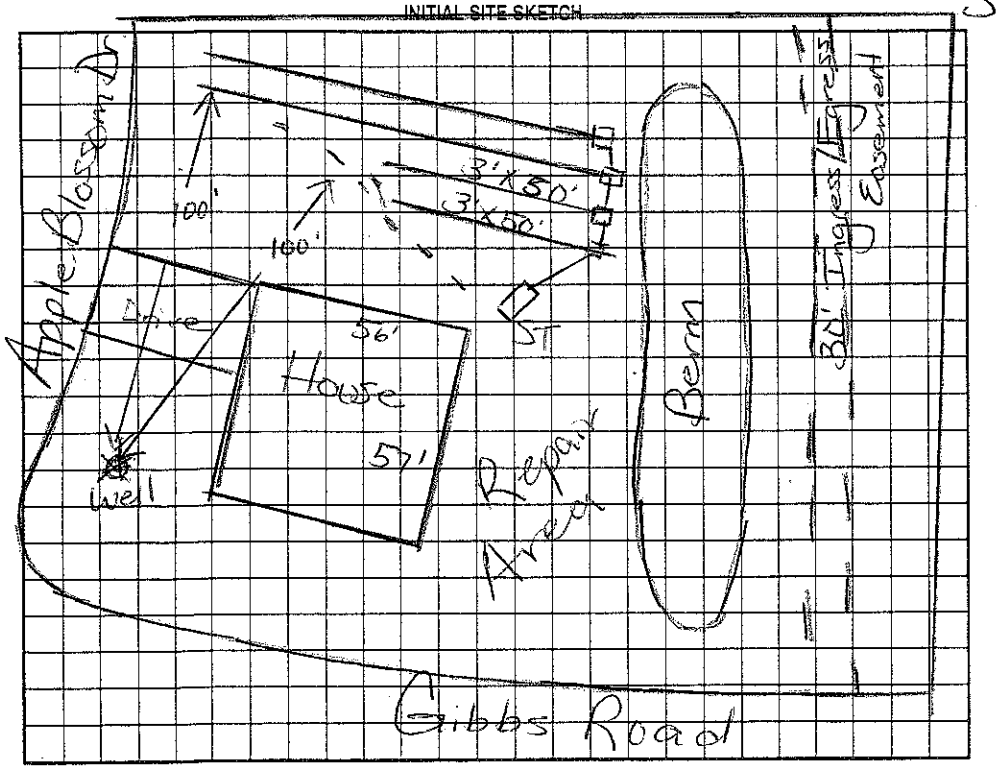


AS BUILT SKETCH

Installed as Drawn used Plastic Chambers

Permit can be suspended or revoked if any false information is supplied toward securing the permit/any unauthorized changes are made to the site/any unauthorized changes are made in the installation of the system. Improvement Permit with plat valid without expiration. Improvement Permit with site plan valid for sixty months. Authorization to Construct is valid for a period equal to that of Improvement Permit – not to exceed sixty months.

Signed: Tina Kruger date 7-29-03 Installed by: Richard Abernathy

Improvement Permit by: Maint. H. Dotson R.S. date 6/11/03 Operation Permit by: Maint. H. Dotson R.S. date 7-29-03

Authorization to Construct by: Maint. H. Dotson R.S. date 6/11/03 Existing System Inspection by: date

HEALTH DEPT. COPY: WHITE OWNER COPY (FINAL): YELLOW OWNER COPY (INITIAL): PINK