IREDELL COUNTY HEALTH DEPARTMENT

Authorization to Construct

STATESVILLE 704-878-5305 | MOORESVILLE 704-664-5281

4646855334

IMPROVEMENT PERMIT / ~~CERTIFICATE OF COMPLETION~~ / OPERATION PERMIT / EXISTING SYSTEM INSPECTION

PROPERTY DESCRIPTION NO. 22968 DATE _____ TAX MAP NO. 2I 4A 12 Watershed: X Yes ☐ No

OWNER OR CONTRACTOR Kendrick W Knight PHONE: Business 892-7373 Home _____

ADDRESS 19701 Hwy 73 Davidson, NC. 28036

LOCATION 21 S TR Watterlynn Rd. on (R) just past Regal Cir.

SUBDIVISION Jim Hager BLOCK / SECTION 1 LOT 12 LOT AREA ~1.69AC SITE CLASS PS DESIGN FLOW 240 L.T.A.R. .35

Septic Tank: 1000 Gallons; STB 794 Date 2/21/96

Pump Tank: _____ Gallons; PT _____ Date _____

Pump Make: _____ Model _____ Serial No. _____

Nitrification Field: No Fields 1 Square Feet 685 Linear Feet 240

No Lines 3 Trench Width 36" Max Trench Bottom Depth 36" Gravel Depth 12"

X New System ☐ Repair System Type: I (II) III IV V VI

System Description: Gravity Conventional

Repair System Description: _____

Maintenance Agreement Required: ☐ Yes ☐ No

X House/Mod. Home No. Bedrooms 2

☐ Mobile Home No. Bathrooms 1

☐ Business No. Employees _____

☐ Other _____


☐ Slab X Crawl Space ☐ Basement w/plumbing ☐ Basement wo/plumbing

Water Supply: X Individual ☐ Community ☐ Public


Comments:

Comments:

INITIAL SITE SKETCH

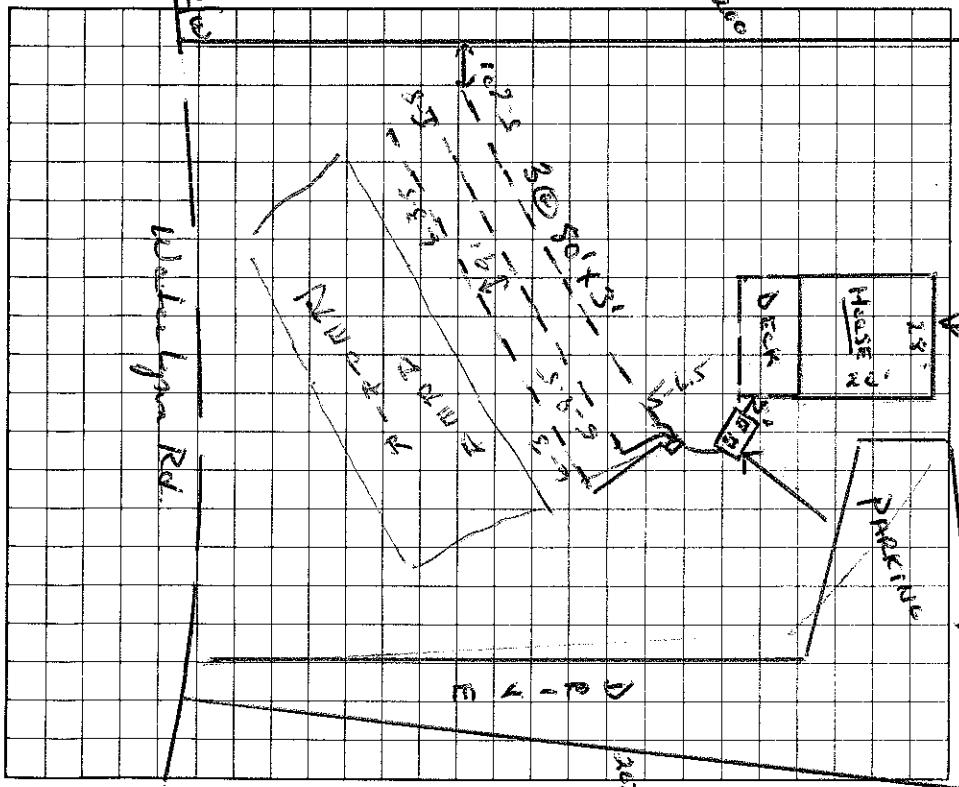

AS BUILT SKETCH

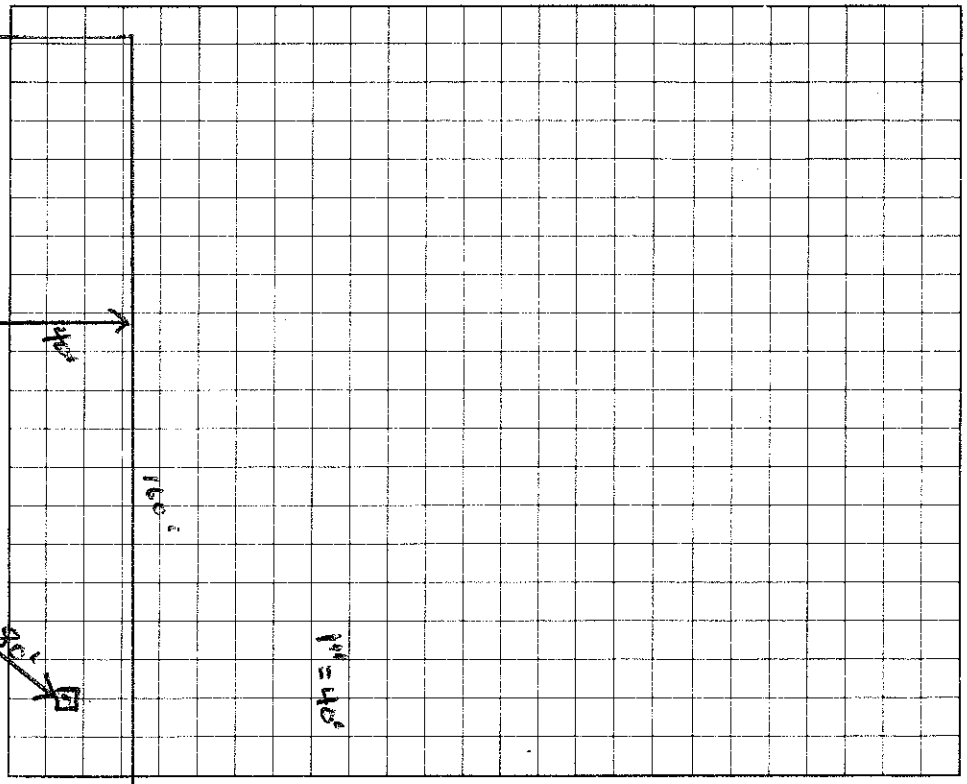

I understand that this permit can be suspended or revoked if any false information is supplied toward securing the permit/any unauthorized changes are made to the site/any unauthorized changes are made in the installation of the system.

Signed: Thornton Brooks Jr

Improvement Permit by: Wesley Sparks RS. date 2/12/96

Authorization to Construct: Wesley Sparks RS. date 2/12/96

Installed by: Russell Construction

Certificate of Completion by: _____ date _____

Operation Permit by: Wesley Sparks RS. date 4/11/96

HEALTH DEPT. COPY: WHITE | INSPECTION COPY (FINAL): GREEN | OWNER COPY (FINAL): YELLOW | INSPECTION COPY (INITIAL): PINK | OWNER COPY (INITIAL): GOLD