IREDELL COUNTY HEALTH DEPARTMENT

STATESVILLE 704-878-5305 MOORESVILLE 704-664-5281

130.00 Fig 8

IMPROVEMENT PERMIT / AUTHORIZATION TO CONSTRUCT / OPERATION PERMIT / EXISTING SYSTEM INSPECTION

PERMIT# 118058 PIN# 4646 89 9417 DATE 1/6/04

OWNER OR CONTRACTOR Jason + Heather Phillips PHONE: Business Home 704-875-9164

ADDRESS 172 Sunfish Dr. Mooresville, NC. 28115

LOCATION 1100 TR Sunfish Dr., 6th Property on R

SUBDIVISION Clipper Run BLOCK / SECTION LOT 7 LOT AREA 4.1AC. SITE CLASS PS DESIGN FLOW 600 L.T.A.R. .3

Septic Tank: 1500 Gallons; STB 339 Date 6/04

Pump Tank: 1500 Gallons; PT 27 Date 8/04

Pump Make: ZOELLER Model N-153 Serial No. 9/041

Nitrification Field: No Fields 1 Square Feet 1500 Linear Feet 500

No Lines 5@100' Trench Width 3' Max Trench Bottom Depth 3' Gravel Depth No

☒ New System ☐ Repair System Type: I, II, III, IV, V, VI

System Description: PM - 25% Reduction

Repair System Description: 16" RPBPS

Maintenance Agreement Required: ☐ Yes ☐ No

☒ House/Mod. Home ☐ Mobile Home ☐ Business ☐ Other

No. Bedrooms 5 No. Bathrooms 3.5 No. Employees


☐ Slab ☐ Crawl Space ☒ Basement w/plumbing ☐ Basement wo/plumbing

Water Supply: ☒ Individual ☐ Public ☐ Community

Comments:/Conditions:

Comments:/Conditions:

INITIAL SITE SKETCH

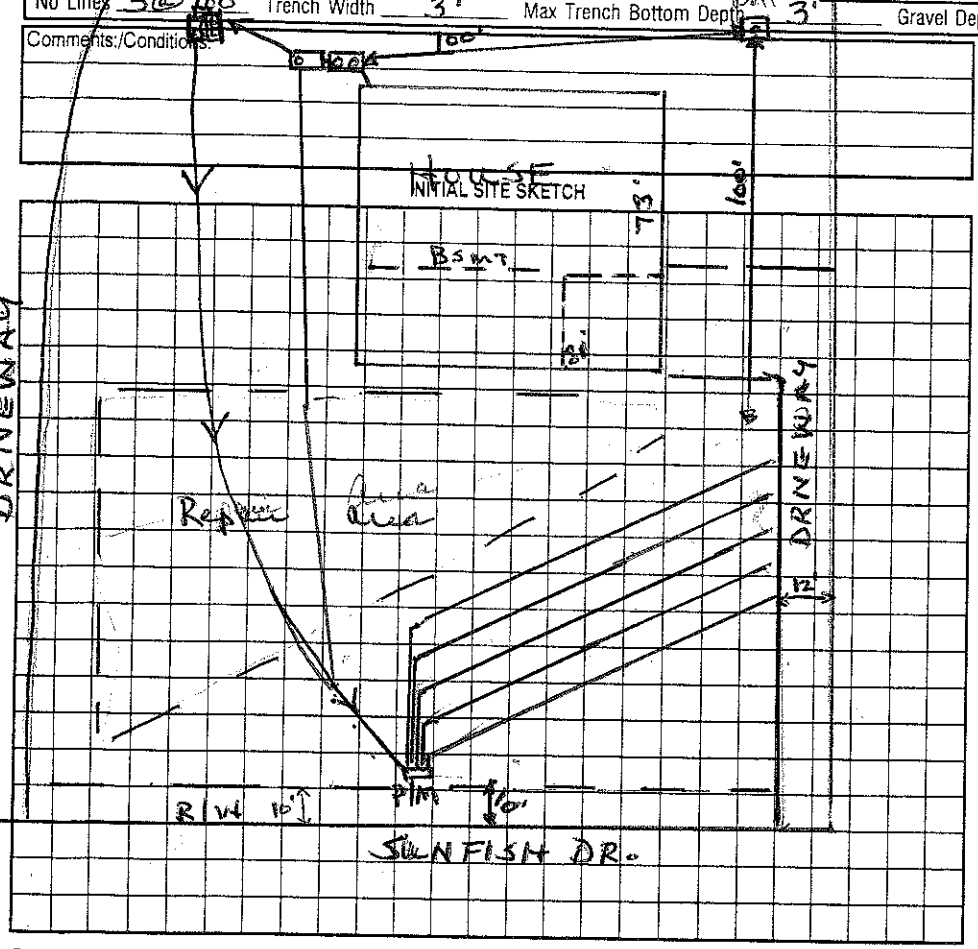

AS BUILT SKETCH

Permit can be suspended or revoked if any false information is supplied toward securing the permit/any unauthorized changes are made to the site/any unauthorized changes are made in the installation of the system. Improvement Permit with plat valid without expiration. Improvement Permit with site plan valid for sixty months. Authorization to Construct is valid for a period equal to that of Improvement Permit – not to exceed sixty months.

Signed: ✱ [signature] date 3-26-04

Improvement Permit by: Wesley Sparks R.S. date 1/6/04

Authorization to Construct by: Wesley Sparks R.S. date 1/6/04

Installed by: Shane Hill

Operation Permit by: Wesley Sparks R.S. date 12/29/04

Existing System Inspection by: date

HEALTH DEPT. COPY: WHITE OWNER COPY (FINAL): YELLOW OWNER COPY (INITIAL): PINK