IREDELL COUNTY HEALTH DEPARTMENT

STATESVILLE 704-878-5305 MOORESVILLE 704-664-5281

IMPROVEMENT PERMIT / AUTHORIZATION TO CONSTRUCT / OPERATION PERMIT / EXISTING SYSTEM INSPECTION

PERMIT# No-REPAIR PIN# 4646928710 DATE 5/5/04

OWNER OR CONTRACTOR Larry Leonard PHONE: Business _____ Home 810-252-5429

ADDRESS 14048 Nichols Rd. Montrose, Mich. 48457

LOCATION 115 S TR Waterlyn Rd. TL Tommyshm., Lean(R) on(L) past "Y" # 142

SUBDIVISION No BLOCK / SECTION _____ LOT _____ LOT AREA _____ SITE CLASS. _____ DESIGN FLOW _____ L.T.A.R. _____

Septic Tank: 1000 Gallons; STB 350 Date 3/14/04
Pump Tank: _____ Gallons; PT _____ Date _____
Pump Make: _____ Model _____ Serial No. _____
Nitrification Field: No Fields 1 Square Feet 900 Linear Feet 300
No Lines 3@100 Trench Width 9' Max Trench Bottom Depth 3' Gravel Depth 12"

☐ New System ☒ Repair System Type: I, II, III, IV, V, VI
System Description: 100'x9' GRAVITY BED
Repair System Description: _____
Maintenance Agreement Required: ☐ Yes ☒ No

☒ House/Mod. Home No. Bedrooms 3
☐ Mobile Home No. Bathrooms 1.5
☐ Business No. Employees _____
☐ Other _____


☐ Slab ☒ Crawl Space ☐ Basement w/plumbing ☐ Basement wo/plumbing

Water Supply:
☒ Individual
☐ Public
☒ Community
Comm WELL


Comments:/Conditions:

Comments:/Conditions:

INITIAL SITE SKETCH

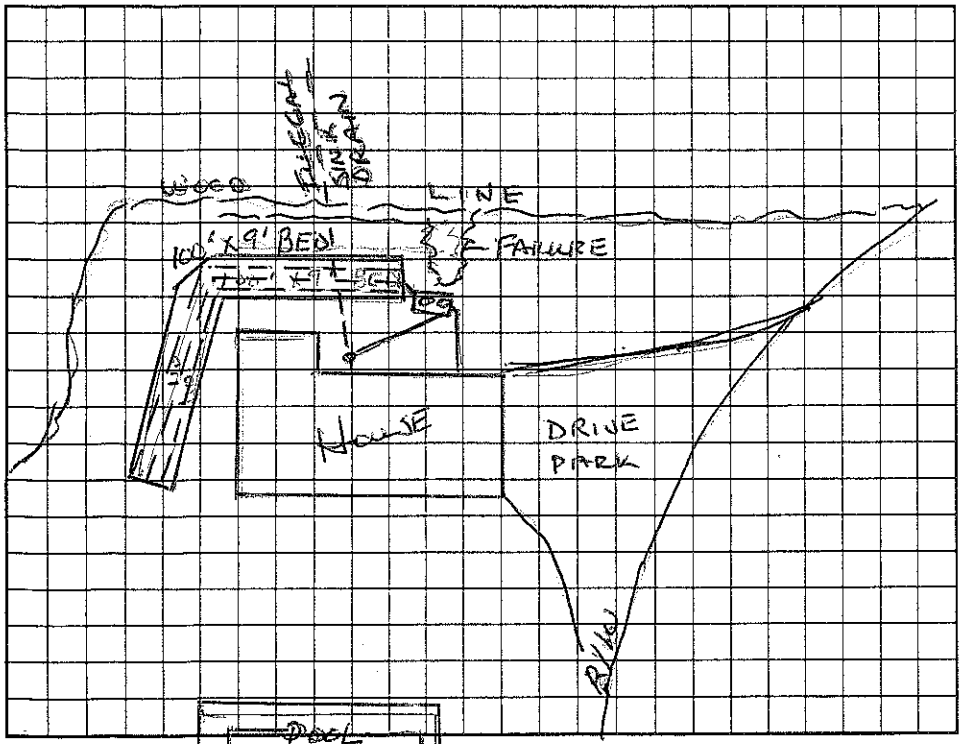

AS BUILT SKETCH

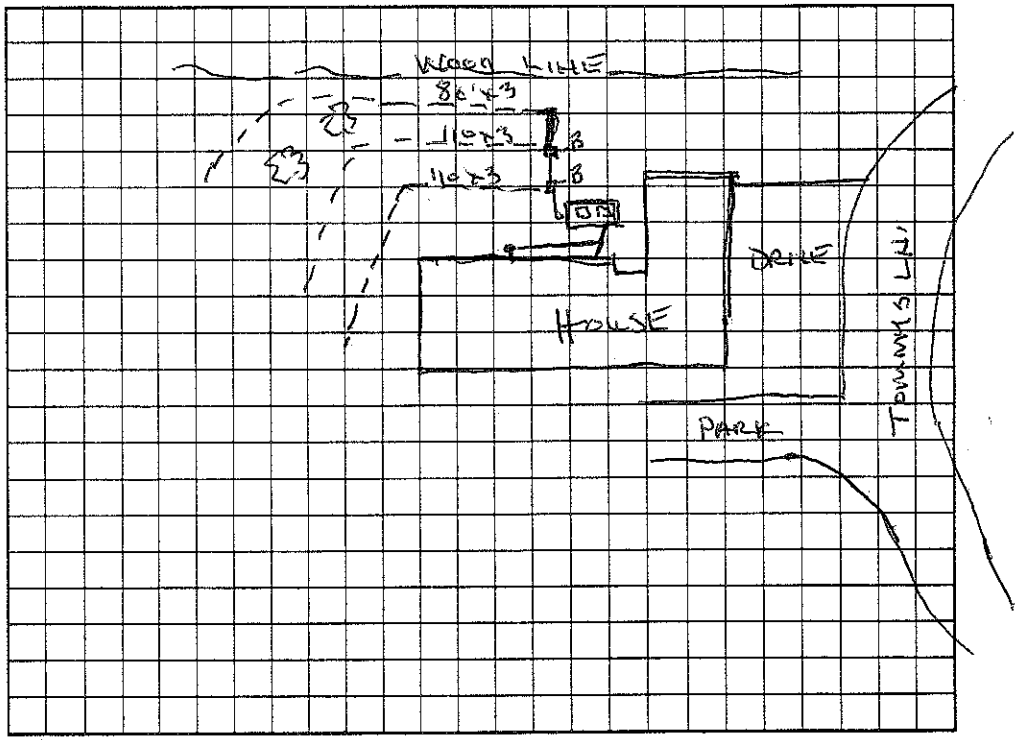

Permit can be suspended or revoked if any false information is supplied toward securing the permit/any unauthorized changes are made to the site/any unauthorized changes are made in the installation of the system. Improvement Permit with plat valid without expiration. Improvement Permit with site plan valid for sixty months. Authorization to Construct is valid for a period equal to that of Improvement Permit – not to exceed sixty months.

Signed: X _____ date 5-10-04

Improvement Permit by: Wesley Sparks RS. date 5/5/04

Authorization to Construct by: Wesley Sparks RS date 5/5/04

Installed by: Piedmont Septic Tank

Operation Permit by: Wesley Sparks RS. date 5/12/04

Existing System Inspection by: _____ date _____

HEALTH DEPT. COPY: WHITE OWNER COPY (FINAL): YELLOW OWNER COPY (INITIAL): PINK