IREDELL COUNTY HEALTH DEPARTMENT

Authorization to Construct 4446-95-1309

STATESVILLE 704-878-5305 MOORESVILLE 704-664-5281

IMPROVEMENT PERMIT / ~~CERTIFICATE OF COMPLETION~~ / OPERATION PERMIT / EXISTING SYSTEM INSPECTION

PROPERTY DESCRIPTION NO. 25441 DATE 11/20/96 TAX MAP NO. 2J 8A 25

OWNER OR CONTRACTOR Forb H Reed Jr. PHONE: Business Watershed: [X] Yes [ ] No

ADDRESS 134 Waterfowl Ln. Mooresville, NC. 28115 Home 663-7751

LOCATION 215 TR Waterlynn Rd TR Regal Dr. 2nd lot on (R)

SUBDIVISION REGAL OAKS BLOCK / SECTION LOT 25 LOT AREA 100 X 200 +/- SITE CLASS. PS DESIGN FLOW 360 L.T.A.R. .25

Septic Tank: 1000 Gallons; STB 825 Date 11/11/96

Pump Tank: Gallons; PT Date

Pump Make: Model Serial No.

Nitrification Field: No Fields 1 Square Feet 480 Linear Feet 240*

No Lines 4 Trench Width 24" Max Trench Bottom Depth 30"

[X] New System [ ] Repair System Type: I, II, (III) IV, V, VI

System Description: RGRAV-16" PPBS

Repair System Description: SAME

Maintenance Agreement Required: [ ] Yes [ ] No

Gravel Depth SAND [ ] Slab [X] Crawl Space [ ] Basement w/plumbing [ ] Basement wo/plumbing

[X] House/Mod. Home No. Bedrooms 3

[ ] Mobile Home No. Bathrooms 2

[ ] Business No. Employees


[ ] Other

Water Supply: [X] Individual [ ] Community [ ] Public

Comments:

Comments:

INITIAL SITE SKETCH

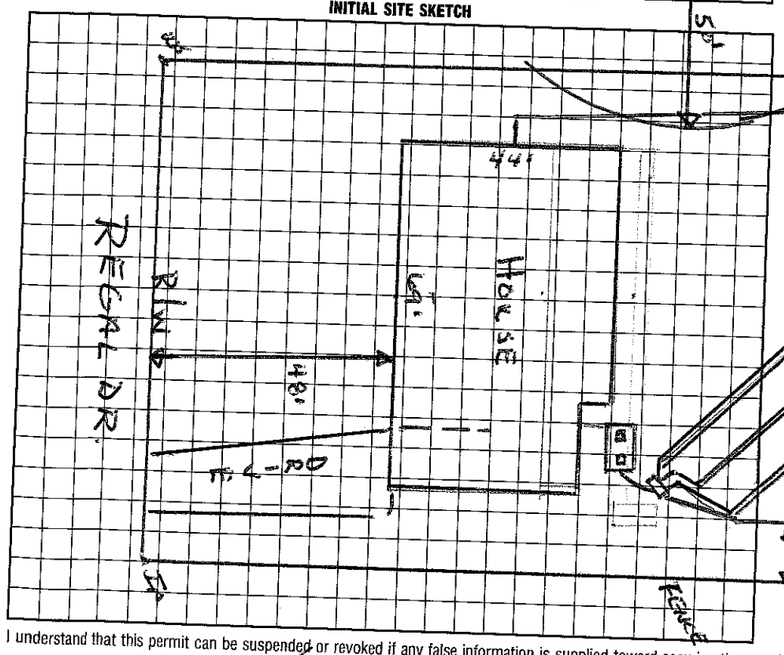

AS BUILT SKETCH

I understand that this permit can be suspended or revoked if any false information is supplied toward securing the permit/any unauthorized changes are made to the site/any unauthorized changes are made in the installation of the system.

Signed: * Forb H. Reed Jr.

Improvement Permit by: Wesley Sparks RS date 11/20/96

Final/Existing System Inspection by: Wesley Sparks RS. date 11/20/96

Installed by: Delbert Barfield

Certificate of Completion by: Wesley Sparks RS. date 5/29/98

Operation Permit by: Wesley Sparks RS. date 5/29/98

HEALTH DEPT. COPY: WHITE INSPECTION COPY (FINAL): GREEN OWNER COPY (FINAL): YELLOW INSPECTION COPY (INITIAL): PINK OWNER COPY (INITIAL): GOLD