IREDELL COUNTY HEALTH DEPARTMENT

STATESVILLE 704-878-5305 MOORESVILLE 704-664-5281

IMPROVEMENT PERMIT / AUTHORIZATION TO CONSTRUCT / OPERATION PERMIT / EXISTING SYSTEM INSPECTION

4100

PERMIT# 132331 PIN# 4646973343 DATE 11/24/06

OWNER OR CONTRACTOR Cory Off PHONE: Business 933-4952 Home 791-4657

ADDRESS 902 Oval Street Kannapolis, NC 28081

LOCATION US 21 South TR (into Huntington Woods) onto Huntington Ln down near end on right

SUBDIVISION Huntington Woods BLOCK / SECTION ____ LOT 11 LOT AREA .65Acre SITE CLASS. Ps DESIGN FLOW 360gpd L.T.A.R. .3

Septic Tank: 1000 Gallons; STB 1012 Date 5/15/06
Pump Tank: 1000 Gallons; PT 17 Date 7/28/06
Pump Make: Goulds Model WE0.5-511 Serial No. K06J1612
Nitrification Field: No. Fields 1 Square Feet 400 Linear Feet 200'
No. Lines 5@40' Trench Width 24" + Max Trench Bottom Depth ~30" Gravel Depth N/A


☒ New System ☐ Repair System Type: I, II, III, IV, V, VI
System Description: Pump-PM-Panel Blk.
Repair System Description: LP panel *See Note
Maintenance Agreement Required: ☐ Yes ☒ No

☒ House/Mod. Home ☐ Mobile Home ☐ Business ☐ Other
No. Bedrooms 3 No. Bathrooms ____ No. Employees ____
☐ Slab ☐ Crawl Space ☒ Basement w/plumbing ☐ Basement wo/plumbing

Water Supply: ☒ Individual ☐ Public ☐ Community

Comments/Conditions: Keep Septic System 100' from well, 50ft from lake & 25ft upslope of basement or 15ft sideslope. Tanks 5ft from deck. Septic Supply line 10ft from basement & 50ft from well

INITIAL SITE SKETCH

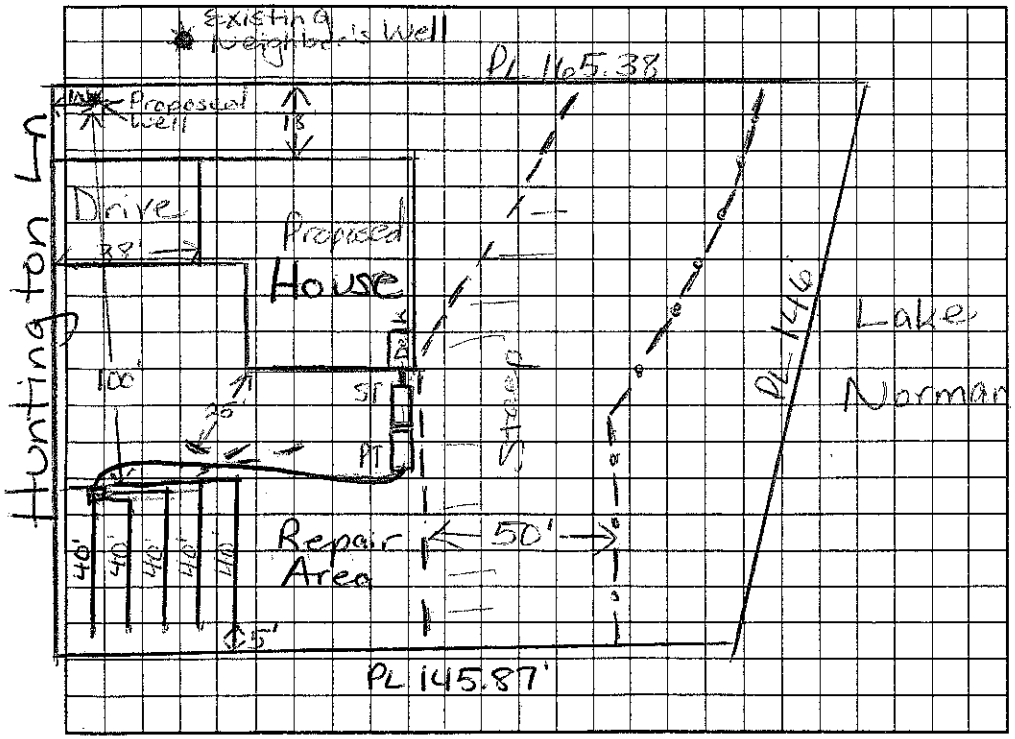

Comments/Conditions: * Note: Subdivision's recorded plat in 1975, therefore 100% Repair not required May go up to 5Ft from PL.
~~**~~ Keep well as close to property line as possible but not ~~5~~ Property line; Stay 25ft from house.
Note: Change to 6 lines @ 35' to meet well setback

AS-BUILT SKETCH

Lines & tanks Checked 11/21/06 by WS
Pressure Checked 11/22/06 WS
Elect & Alarm By 12/1/06 by WS

Permit can be suspended or revoked if any false information is supplied toward securing the permit/any unauthorized changes are made to the site/any unauthorized changes are made in the installation of the system. Improvement Permit with plat valid without expiration. Improvement Permit with site plan valid for sixty months. Authorization to Construct is valid for a period equal to that of Improvement Permit – not to exceed sixty months.

Signed: [signature] date 1/31/06 Installed by: Tommy Frye

Improvement Permit by: Maria H. Dotson RS date 11/24/06 Operation Permit by: Wesley Sparkes by Maria Dotson date 12/12/06

Authorization to Construct by: Maria H. Dotson RS date 11/24/06 Existing System Inspection by: ____ date ____

HEALTH DEPT. COPY: WHITE OWNER COPY (FINAL): YELLOW OWNER COPY (INITIAL): PINK