IREDELL COUNTY HEALTH DEPARTMENT

AUTHORIZATION TO CONSTRUCT

STATESVILLE 704-878-5305 MOORESVILLE 704-664-5281

(4:30)

IMPROVEMENT PERMIT / ~~CERTIFICATE OF COMPLETION~~ / OPERATION PERMIT / EXISTING SYSTEM INSPECTION

PROPERTY DESCRIPTION NO. 24320- MOORESVILLE DATE 1/28/97 TAX MAP NO. 2511 A 9 4646 99 0286 Watershed: ☑ Yes ☐ No

OWNER OR CONTRACTOR DIANNE UMBARGER PHONE: Business _____ Home 664-1385

ADDRESS 192 SUNFISH DR MOORESVILLE NC 28115

LOCATION BRANLEY SCHOOL RD - TL SUNFISH - ON RT NEAR END

SUBDIVISION CLEPPERSENN BLOCK / SECTION _____ LOT 9 LOT AREA 51,000 FT SITE CLASS. PS DESIGN FLOW 360 GPD L.T.A.R. .36 PD/FT2

Septic Tank: 1000 Gallons; STB 194 Date 10/10/97

Pump Tank: 1000 Gallons; PT 27 Date 10/8/97

Pump Make: _____ Model _____ Serial No. _____

Nitrification Field: No Fields 1 Square Feet 1200 Linear Feet 400

No Lines 5 Trench Width 36" Max Trench Bottom Depth 36" Gravel Depth 12"

☑ New System ☐ Repair System Type: I, II, III, IV, V, VI

System Description: PUMP CONVENTIONAL

Repair System Description: PUMP PANEL

Maintenance Agreement Required: ☐ Yes ☑ No

☑ House/Mod. Home No. Bedrooms 3

☐ Mobile Home No. Bathrooms 3.5

☐ Business No. Employees ____

☐ Other _____

☐ Slab ☑ Crawl Space ☑ Basement w/plumbing ☐ Basement wo/plumbing

Water Supply: ☑ Individual ☐ Community ☐ Public

Comments:


Comments:

(HOUSE MOVED 25' TO LEFT)

~~UPPER 3 LINES CHANGED - ST check~~

(WAS - BEST.)

INITIAL SITE SKETCH

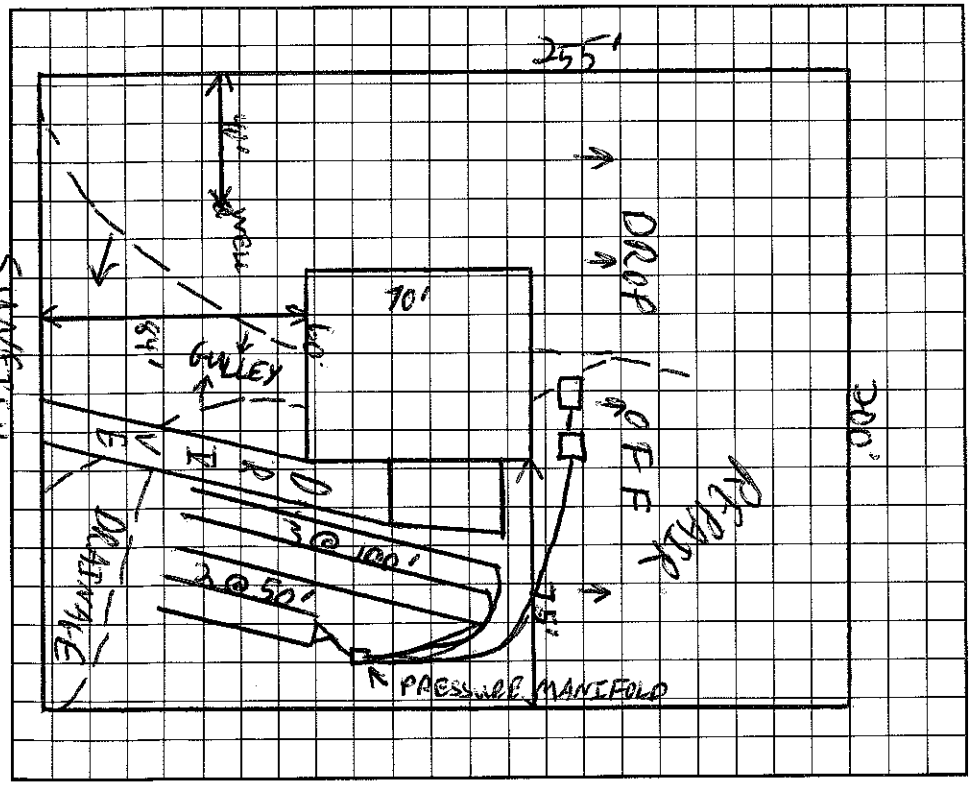

AS BUILT SKETCH

I understand that this permit can be suspended or revoked if any false information is supplied toward securing the permit/any unauthorized changes are made to the site/any unauthorized changes are made in the installation of the system. Improvement Permit is valid for 60 months from date of issuance.

Signed: Diana Umbarger

Installed by: DAVID UMBARGER

Improvement Permit by: C. Bl[illegible] date 1/28/97

Existing System Inspection by: C. Bl[illegible] date 1/28/97

AUTHORIZATION TO CONSTRUCT

Certificate of Completion by: _____ date _____

Operation Permit by: C. Bl[illegible] date 3/2/98

HEALTH DEPT. COPY: WHITE INSPECTION COPY (FINAL): GREEN OWNER COPY (FINAL): YELLOW INSPECTION COPY (INITIAL): PINK OWNER COPY (INITIAL): GOLD