IREDELL COUNTY HEALTH DEPARTMENT

STATESVILLE 704-878-5305 MOORESVILLE 704-664-5281

IMPROVEMENT PERMIT / AUTHORIZATION TO CONSTRUCT / OPERATION PERMIT / EXISTING SYSTEM INSPECTION

PERMIT# 6359 PIN# 4646994949 DATE 7/7/99

OWNER OR CONTRACTOR Donato Petrosino PHONE: Business _____ Home _____

ADDRESS 155 Sunfish Dr. Mooresville NC 28117

LOCATION _____

SUBDIVISION Petrosino BLOCK / SECTION — LOT 37 LOT AREA 2.33 SITE CLASS. PS DESIGN FLOW 360 L.T.A.R. .3

Septic Tank: 1000 Gallons; STB 312 Date 7/23/99
Pump Tank: _____ Gallons; PT _____ Date _____
Pump Make: _____ Model _____ Serial No. _____
Nitrification Field: No Fields 1 Square Feet 1200 Linear Feet 400
No Lines 5@80 Trench Width 36 Max Trench Bottom Depth 36 Gravel Depth 12

☒ New System ☐ Repair System Type: I (II) III, IV, V, VI
System Description: Gravel / ~~Conv.~~ Conv.
Repair System Description: Panel / Chamber
Maintenance Agreement Required: ☐ Yes ☐ No


☒ House/Mod. Home No. Bedrooms 3
☐ Mobile Home No. Bathrooms 2
☐ Business No. Employees ____
☐ Other _____
☐ Slab ☐ Crawl Space ☐ Basement w/plumbing ☐ Basement wo/plumbing

Water Supply:
☒ Individual
☐ Public
☐ Community


Comments:/Conditions: Riser & filter installed on tank

Comments:/Conditions: Tanks & line checked 10/19/99 MD

INITIAL SITE SKETCH

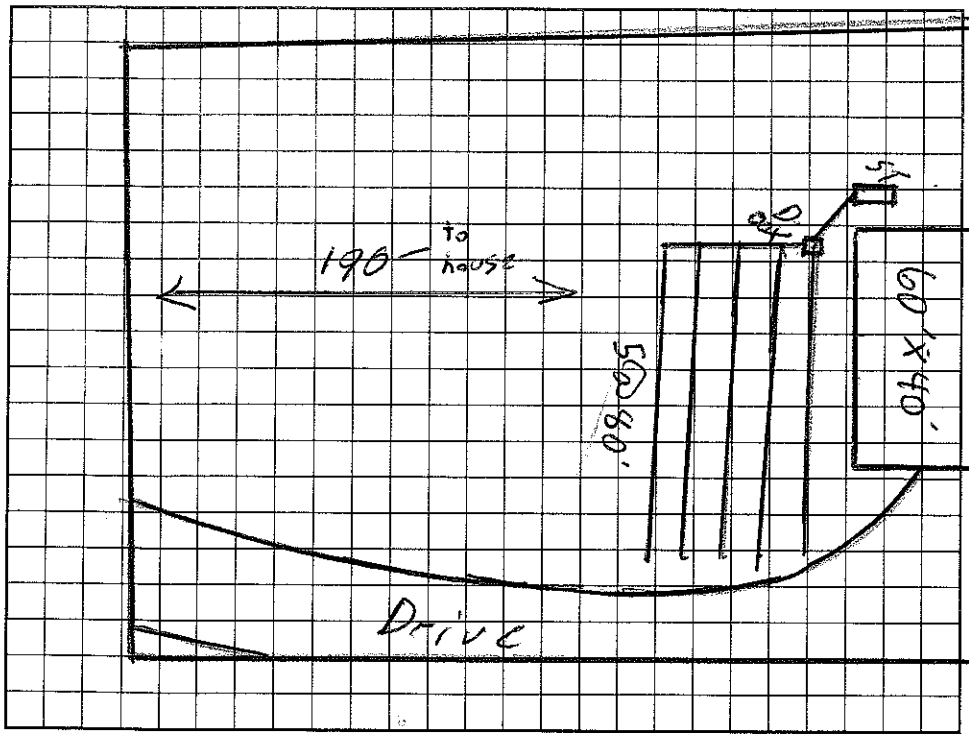

AS BUILT SKETCH

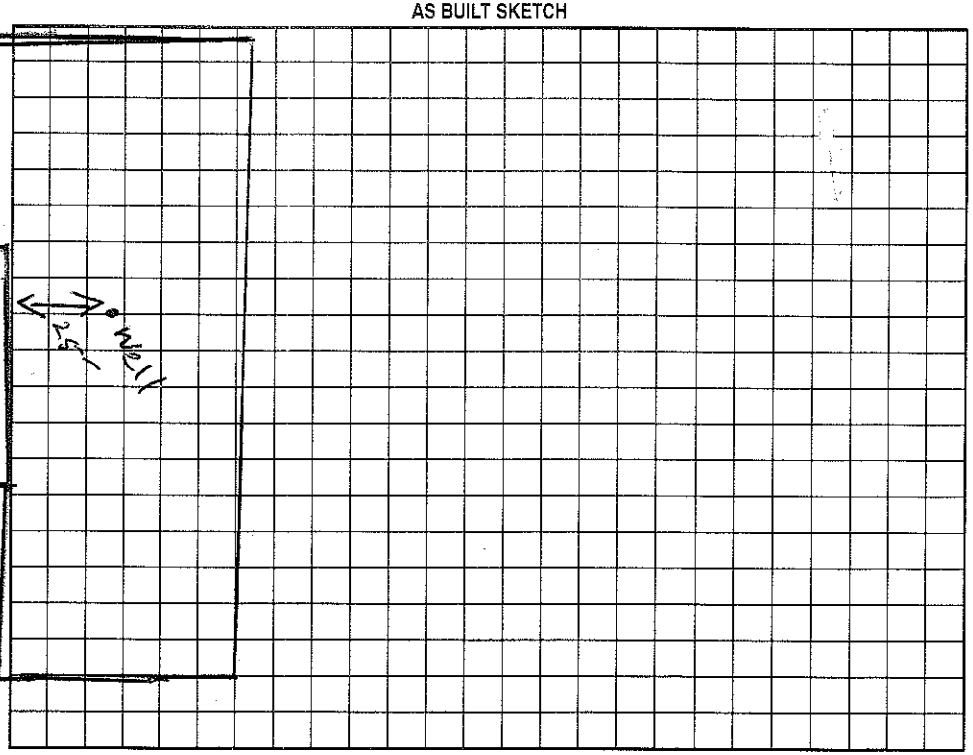

Permit can be suspended or revoked if any false information is supplied toward securing the permit/any unauthorized changes are made to the site/any unauthorized changes are made in the installation of the system. Improvement Permit with plat valid without expiration. Improvement Permit with site plan valid for sixty months. Authorization to Construct is valid for a period equal to that of Improvement Permit – not to exceed sixty months.

Signed: _____ date 7/7/99 Installed by: Curt Dunning

Improvement Permit by: Jeff Mayo date 7/7/99 Operation Permit by: Maria H. Dickson RS date 10/19/99

Authorization to Construct by: Jeff Mayo date 7/7/99 Existing System Inspection by: _____ date _____

HEALTH DEPT. COPY: WHITE OWNER COPY (FINAL): YELLOW OWNER COPY (INITIAL): PINK