PIN# 4646-99-5078

...DELL COUNTY HEALTH DEPARTMENT

STATESVILLE 704-878-5305 MOORESVILLE 704-664-5281

IMPROVEMENT PERMIT / CERTIFICATE OF COMPLETION / OPERATION PERMIT / EXISTING SYSTEM INSPE...ION

PROPERTY DESCRIPTION NO. 2537 DATE Dec 14, '93 TAX MAP NO. 2JII A 28A Watershed: ☑ Yes ☐ No

OWNER OR CONTRACTOR William Mallen PHONE: Business _____ Home 663-5692 L.N.

ADDRESS 322 Mallard Head Pl, Mooresville

LOCATION 21 S. , TR 1100 to Sunfish on left just before jct w/ Clippers Lane

SUBDIVISION Clippers Run BLOCK / SECTION 1 LOT 28 A LOT AREA 2.18 AC SITE CLASS. PB DESIGN FLOW 360 gpd L.T.A.R. .3

Septic Tank: 1000 Gallons; STB 744 Date 5/3/94

Pump Tank: _____ Gallons; PT _____ Date _____

Pump Make: _____ Model _____ Serial No. _____

Nitrification Field: No Fields 1 Square Feet 1200 Linear Feet 400

No Lines 3 Trench Width 36" Max Trench Bottom Depth 36" Gravel Depth 12"

☑ New System ☐ Repair System Type: I, II, III, IV, V, VI

System Description: gravity conventional

Repair System Description: SAME

Maintenance Agreement Required: ☐ Yes ☑ No

☑ House/Mod. Home No. Bedrooms 3

☐ Mobile Home No. Bathrooms 2½

☐ Business No. Employees _____

☐ Other _____


☑ Slab ☐ Crawl Space ☐ Basement w/plumbing ☐ Basement wo/plumbing

Water Supply: ☑ Individual ☐ Community ☐ Public

Comments:

Comments: Installed as drawn.

INITIAL SITE SKETCH

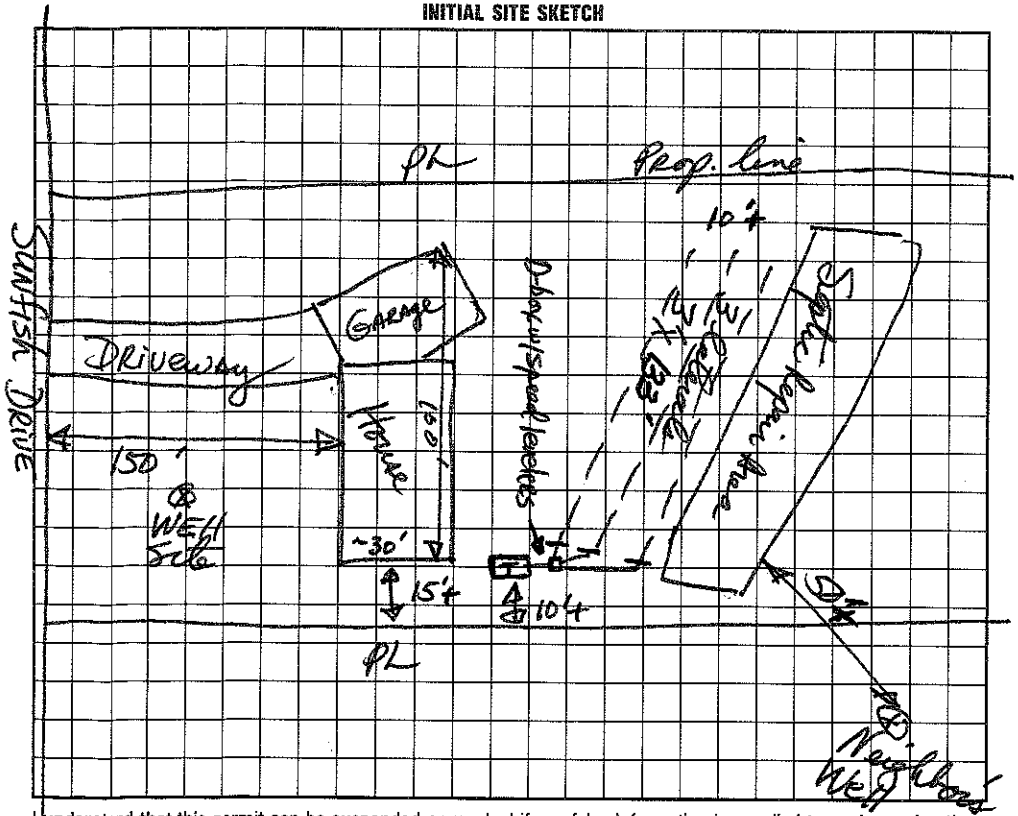

AS BUILT SKETCH

I understand that this permit can be suspended or revoked if any false information is supplied toward securing the permit/any unauthorized changes are made to the site/any unauthorized changes are made in the installation of the system. Improvement Permit is valid for 60 months from date of issuance.

Signed: X William E. Mallen

Improvement Permit by: Mark R. Hunn, RS date 12/14/93

Existing System Inspection by: _____ date _____

Installed by: Dennen Plumbing Co.

Certificate of Completion by: Wally Sparks RS date 6/3/94

Operation Permit by: _____ date _____

HEALTH DEPT. COPY: WHITE INSPECTION COPY (FINAL): GREEN OWNER COPY (FINAL): YELLOW INSPECTION COPY (INITIAL): PINK OWNER COPY (INITIAL): GOLD