PIN# 4646-99-5616

4:00 – 4:30

IREDELL COUNTY HEALTH DEPARTMENT

STATESVILLE 704-878-5305 MOORESVILLE 704-664-5281

IMPROVEMENT PERMIT / CERTIFICATE OF COMPLETION / OPERATION PERMIT / EXISTING SYSTEM INSPECTION

PROPERTY DESCRIPTION NO. 4587 DATE 5/6/97 TAX MAP NO. 2511-A-30 Watershed: ☒ Yes ☐ No

OWNER OR CONTRACTOR James Gaghan PHONE: Business _____ Home (704) 662-3653

ADDRESS 151 Saddle Rd. J Mooresville NC.

LOCATION Brawley School Rd TL Sunfish Dr. part of Lot 30 next to 145 Sunfish Dr (left side of street)

SUBDIVISION Clippers Run BLOCK / SECTION _____ LOT 30 LOT AREA 1.836 Acre SITE CLASS. P.S. DESIGN FLOW 480 gpd L.T.A.R. .3

Septic Tank: 1000 Gallons; STB 794 Date 7/3/97

Pump Tank: _____ Gallons; PT _____ Date _____

Pump Make: _____ Model _____ Serial No. _____

Nitrification Field: No Fields 1 Square Feet 1620 Linear Feet 540'

No Lines 6 Trench Width 3' Max Trench Bottom Depth 18" Gravel Depth 12"

☒ New System ☐ Repair System Type: I, II, III, IV, V, VI

System Description: Gravity Conventional

Repair System Description: Gravity Conventional

Maintenance Agreement Required: ☐ Yes ☒ No

☒ House/Mod. Home No. Bedrooms 4

☐ Mobile Home No. Bathrooms 3.5

☐ Business No. Employees ____

☐ Other _____


☐ Slab ☒ Crawl Space ☐ Basement w/plumbing ☐ Basement wo/plumbing

Water Supply: ☒ Individual ☐ Community ☐ Public

Comments:

Comments:

INITIAL SITE SKETCH Scale 1:100

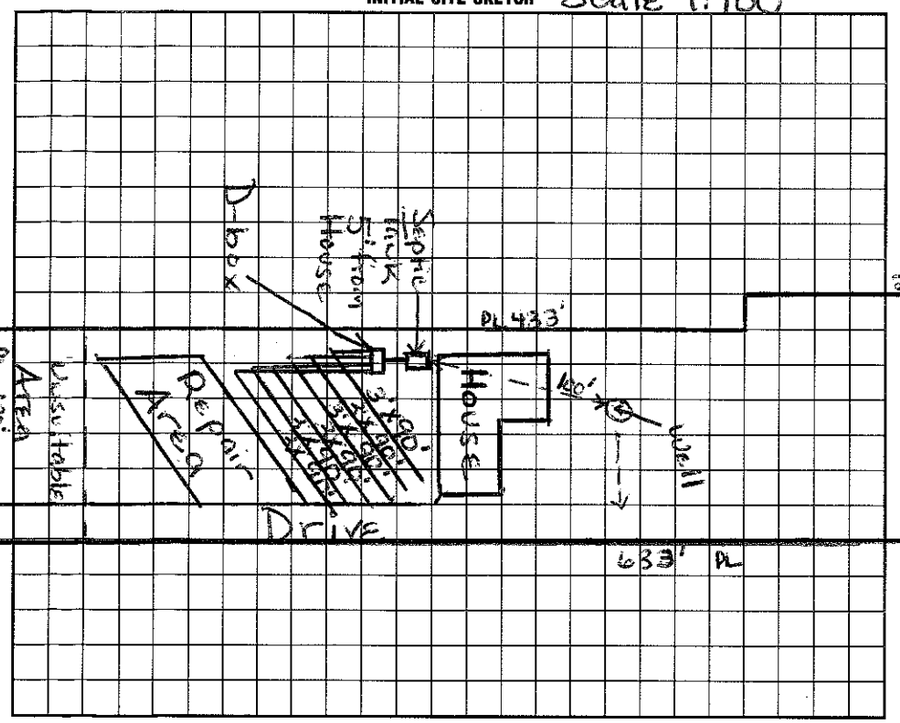

AS BUILT SKETCH

Installed As Drawn

I understand that this permit can be suspended or revoked if any false information is supplied toward securing the permit/any unauthorized changes are made to the site/any unauthorized changes are made in the installation of the system. Improvement Permit is valid for 60 months from date of issuance.

Signed: James F. Gaghan

Improvement Permit by: Maria H.H. Dotson date 5/6/97

~~Existing System Inspection by:~~ Maria H.H. Dotson date 5/6/97

Auth. to Construct

Installed by: F J Ervin

Certificate of Completion by: Maria H.H. Dotson date 10/1/97

Operation Permit by: Maria H.H. Dotson date 10/1/97

HEALTH DEPT. COPY: WHITE INSPECTION COPY (FINAL): GREEN OWNER COPY (FINAL): YELLOW INSPECTION COPY (INITIAL): PINK OWNER COPY (INITIAL): GOLD