IREDELL COUNTY HEALTH DEPARTMENT

STATESVILLE 704-878-5305 MOORESVILLE 704-664-5281

2130

IMPROVEMENT PERMIT / AUTHORIZATION TO CONSTRUCT / OPERATION PERMIT / EXISTING SYSTEM INSPECTION

PERMIT # 164252 PIN # 4647003004 DATE 12-13-2010

OWNER or APPLICANT Michael Melicia (UVC) PHONE: Business 704 953-4555 Home:

OWNER or APPLICANT ADDRESS P.O. Box 518 Davidson, NC 28036

LOCATION / DIRECTIONS Brawley School Rd TL Farmstead TR on Pondhaven on Corner #106 Pondhaven Cir.

SUBDIVISION Farmstead Est BLOCK / SECTION LOT # 32 LOT AREA ~1Ac. DESIGN FLOW 480gpd L.T.A.R. .35

Exist / Add to Exist. System

Septic Tank 1000 Gallons: STB Date

Pump Tank Gallons: PT Date

Pump Make Model Serial #

Nitrification Field No Fields 1 No Lines 2 Linear Feet 130ft

Trench Width 36" Max. Trench Bottom Depth 36" Gravel Depth N/A

☐ New System ☐ Repair ☒ Expansion System Type I (II) III IV V VI

System Description Gravity - 25% Reduction

Repair System Description: Pump - PPBPS

Maintenance Agreement Required ☐ YES ☒ NO

☒ GRAVITY ☐ PRESSURE

☒ Residence No. Bedrooms 4

☐ Business No. Persons

☐ Other No. Employees

☐ Slab ☐ Crawl Space


☐ Basement w/plumbing ☐ Basement w/o plumbing

Water Supply: ☒ Private ☐ Public ☐ Community

Comments / Conditions: Upgrading House to 4 Bedroom Must add 100ft of Drainfield; Plus abandoned Drainfield in front of House ~25ft from Basement wall

Comments / Conditions: Drainfield in front of House Setback = 25ft to Basement wall. Side Slope of House, Drainfield Setback = 15ft. "Properly abandon" Drainfield in front of House <25ft.

INITIAL SITE SKETCH

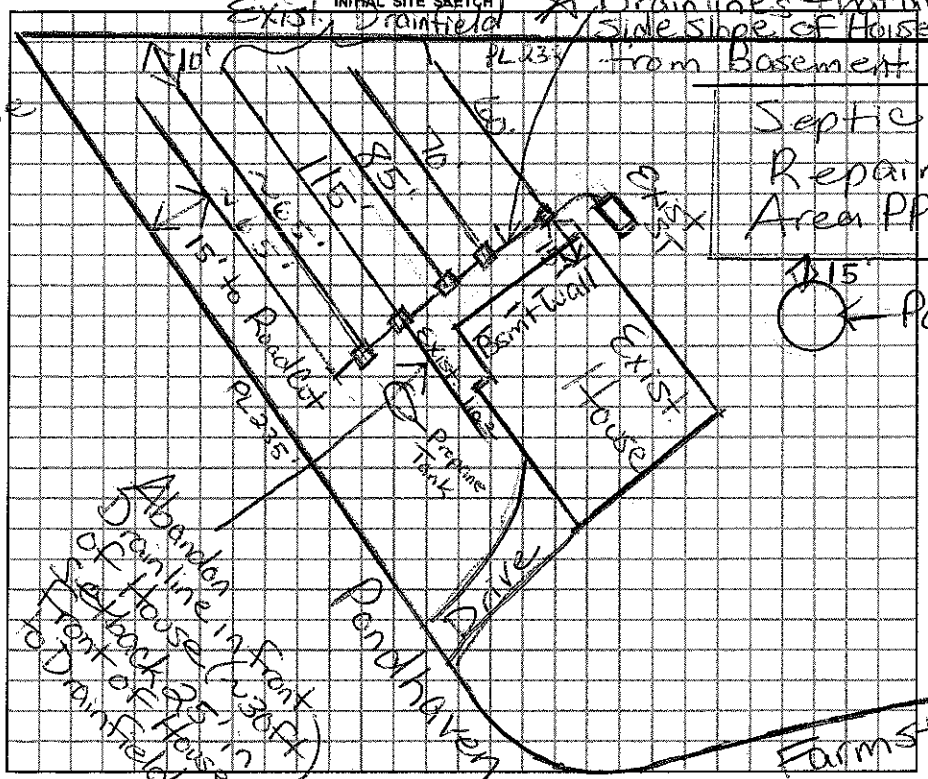

AS BUILT SKETCH

Installed Quick 4 Essentially as Drawn Capped part of Drainline that was to close to Basement.

*Not to Scale

Permit can be suspended or revoked if any false information is supplied toward securing the permit / any unauthorized changes are made to the site / any unauthorized changes are made in the installation of the system.

☐ *IMPROVEMENT PERMIT w / plat valid without expiration.* ☐ *IMPROVEMENT PERMIT w / site plan valid for 60 mos.* ☐ *AUTHORIZATION TO CONSTRUCT valid for period equal to IMPROVEMENT PERMIT-not to exceed 60 mo.*

Owner / Applicant Signature: Date 12/13/10

Improvement Permit by: Maria H. Dotson RS Date 12/13/10

Authorzation to Construct by: Maria H. Dotson RS Date 12/13/10

Installed by: Rowan Septic

Operation Permit by: Maria H. Dotson REHS Date: 4/4/11

Existing System Inspected by: Date:

YOU SHOULD CONTACT A LOCATOR SERVICE PRIOR TO ANY EXCAVATION.

WHITE COPY Environmental Health YELLOW COPY (Final) Owner / Applicant PINK COPY (Initial) Owner / Applicant