IREDELL COUNTY HEALTH DEPARTMENT

STATESVILLE 704-878-5305 MOORESVILLE 704-664-5281

IMPROVEMENT PERMIT / CERTIFICATE OF COMPLETION / OPERATION PERMIT / EXISTING SYSTEM INSPECTION

PROPERTY DESCRIPTION NO. 20877 DATE 5/20/95 TAX MAP NO. 2K 19 A 12 4647006005 Watershed: ☐ Yes ☒ No

OWNER OR CONTRACTOR Martha Landis PHONE: Business _____ Home 664-7220

ADDRESS 628 Duke of Pines Dr. Mooresville, NC. 28115

LOCATION Pond HAVEN Dr off Farmstead TR, 2nd lot on R

SUBDIVISION Farmstead BLOCK / SECTION II LOT 12 LOT AREA ~ .75 Ac SITE CLASS. P DESIGN FLOW 360 L.T.A.R. .3

Septic Tank: 1000 Gallons; STB ~~1944HH~~ Date 5/95

Pump Tank: 1000 Gallons; PT 47 Date 5/95

Pump Make: Gould Model WE05II HH Serial No. L9405523

Nitrification Field: No Fields 1 Square Feet 1200 Linear Feet ~~200~~

No Lines 4 Trench Width 24" Max Trench Bottom Depth 36" Gravel Depth 6" Stone

☒ New System ☐ Repair System Type: I, II, III, IV, V, VI

System Description: Pressure Pond

Repair System Description: Same

Maintenance Agreement Required: ☐ Yes ☒ No

☒ House/Mod. Home No. Bedrooms 3

☐ Mobile Home No. Bathrooms 2

☐ Business No. Employees _____

☐ Other _____


☐ Slab ☐ Crawl Space ☐ Basement w/plumbing ☒ Basement wo/plumbing

Water Supply: ☒ Individual ☐ Community ☐ Public

Comments: Location 1 or 2 ok for S/T P/T mounding 50' from D/H
Pressure Pond - Pressure Pond Repair
124 GALS/DOSE ~ 6" DRAWDOWN

Comments:

INITIAL SITE SKETCH

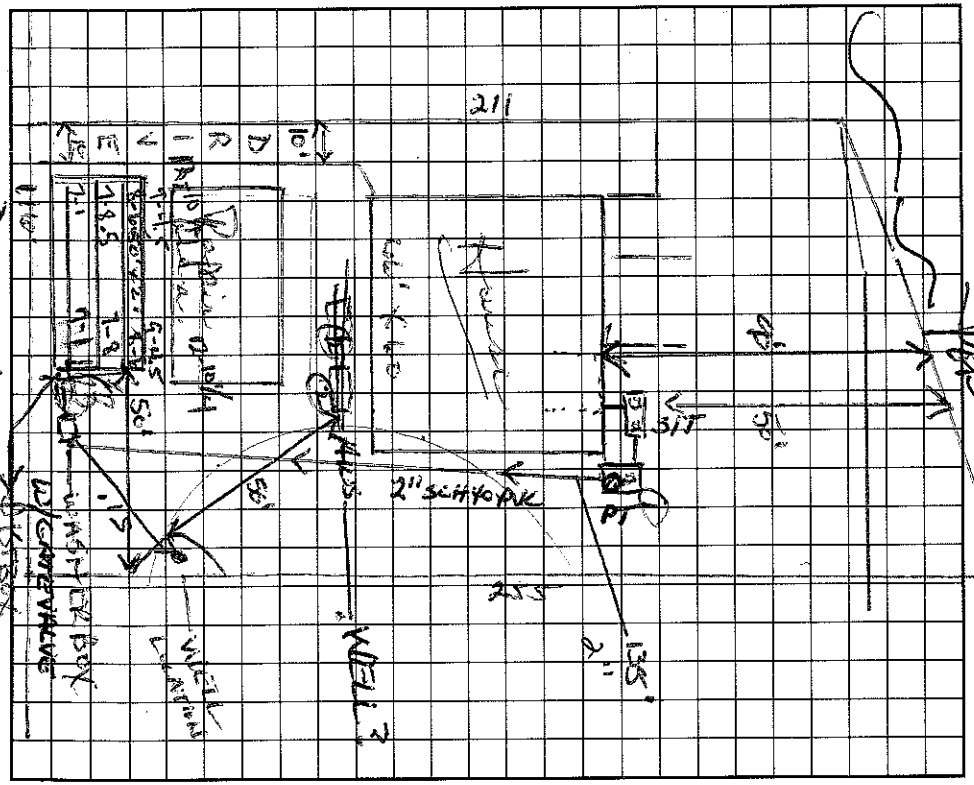

AS BUILT SKETCH

I understand that this permit can be suspended or revoked if any false information is supplied toward securing the permit/any unauthorized changes are made to the site/any unauthorized changes are made in the installation of the system. Improvement Permit is valid for 60 months from date of issuance.

Signed: Martha S Landis

Improvement Permit by: Wesley Sparks R.S. date 4/20/95

Existing System Inspection by: _____ date _____

Installed by: F J Erwin

Certificate of Completion by: Wesley Sparks R.S. date 9/22/95

Operation Permit by: _____ date _____

HEALTH DEPT. COPY: WHITE INSPECTION COPY (FINAL): GREEN OWNER COPY (FINAL): YELLOW INSPECTION COPY (INITIAL): PINK OWNER COPY (INITIAL): GOLD