IREDELL COUNTY HEALTH DEPARTMENT

Authorization to Construct

STATESVILLE 704-878-5305 | MOORESVILLE 704-664-5281

4647006960

IMPROVEMENT PERMIT / ~~CERTIFICATE OF COMPLETION~~ / OPERATION PERMIT / EXISTING SYSTEM INSPECTION

PROPERTY DESCRIPTION NO. Repair DATE 4/2/96 TAX MAP NO. 2K 16A 12 Watershed: [X] Yes [ ] No

OWNER OR CONTRACTOR Carol C Hawkins PHONE: Business 527-3435 Home

ADDRESS 124 Charleston Dr. Mooresville, NC 28115

LOCATION Brawley Sch TL Charleston Dr., 1st house on (R)

SUBDIVISION Williamsburg Block / SECTION LOT 12 LOT AREA Empty SITE CLASS. DESIGN FLOW L.T.A.R.

Septic Tank: Empty Gallons; STB Date

Pump Tank: Gallons; PT Date

Pump Make: Model Serial No.

Nitrification Field: No Fields 1 Square Feet 300 Linear Feet 900

No Lines 3 Trench Width 36 Max Trench Bottom Depth 30" Gravel Depth 12"

[ ] New System [X] Repair System Type: I (II) III. IV. V. VI

System Description: CONV -

Repair System Description:

Maintenance Agreement Required: [ ] Yes [X] No

[X] House/Mod. Home No. Bedrooms 3

[ ] Mobile Home No. Bathrooms 3

[ ] Business No. Employees

[ ] Other

[ ] Slab [X] Crawl Space [ ] Basement w/plumbing [ ] Basement wo/plumbing

Water Supply: [X] Individual [ ] Community [ ] Public

Comments (1) Bull Run Valve - reset D/B


(2) New Dist Box - all lines need speed levelers

(3) Schedule 40 PVC from Bull Run Valve to D/Box

Very poor soil conditions Keep Shallow

Comments:

INITIAL SITE SKETCH

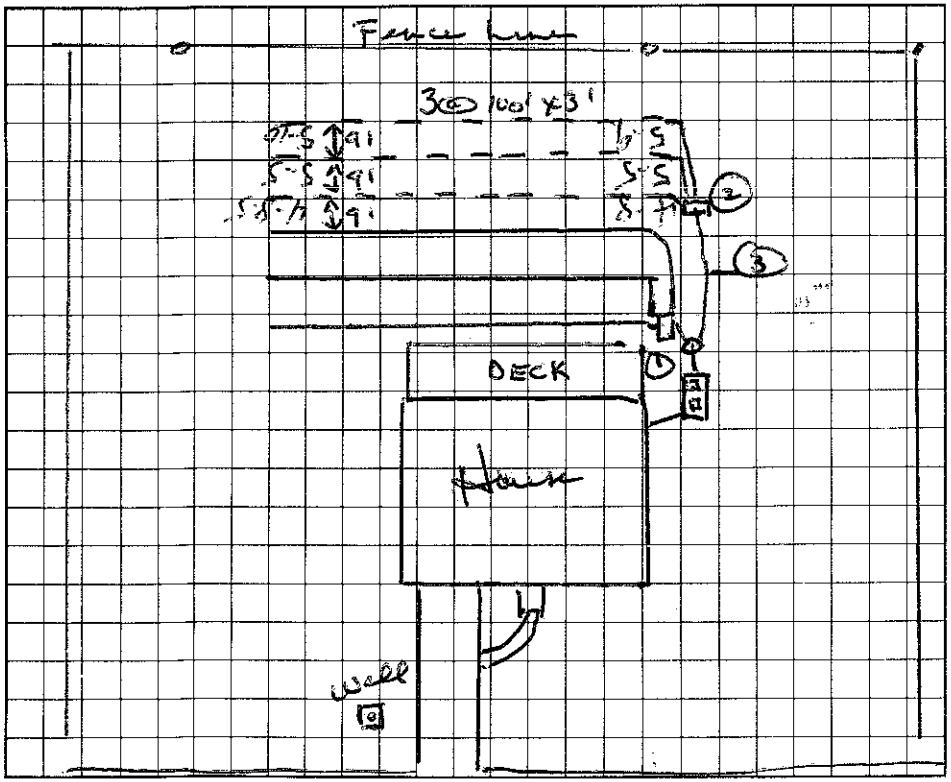

AS BUILT SKETCH

I understand that this permit can be suspended or revoked if any false information is supplied toward securing the permit/any unauthorized changes are made to the site/any unauthorized changes are made in the installation of the system.

Signed:

Installed by: F J Erwin

Improvement Permit by:

Authorization to Construct Wesley Sparks date 4/2/96

Certificate of Completion by: date

Operation Permit by: Wesley Sparks RS date 11/13/96

Existing System Inspection by: date

HEALTH DEPT. COPY: WHITE | INSPECTION COPY (FINAL): GREEN | OWNER COPY (FINAL): YELLOW | INSPECTION COPY (INITIAL): PINK | OWNER COPY (INITIAL): GOLD