4647008669

# IREDELL COUNTY HEALTH DEPARTMENT

STATESVILLE 704-878-5305 MOORESVILLE 704-664-5281

## IMPROVEMENT PERMIT / CERTIFICATE OF COMPLETION / OPERATION PERMIT / EXISTING SYSTEM INSPECTION

PROPERTY DESCRIPTION NO. 16787 DATE August 10, '93 TAX MAP NO. 2K-16-A-10

OWNER OR CONTRACTOR Kelly Parker PHONE: Business Home 664-3696

ADDRESS Rt 8, Box 65, Mooresville

LOCATION SR 1160, past Brawley School Rd Charlton Dr. on right near end

SUBDIVISION Williamsburg Estates BLOCK / SECTION LOT 10 LOT AREA 2/65 X 203 SITE CLASS. PS L.T.A.R. .3

Water Supply: ☑ Individual ☐ Community ☐ Public

Septic Tank: 1000 Gallons; STB 358(ACP) Date 7-6-93

Pump Tank: Gallons; PT Date

Nitrification Field: No Fields 1 Square Feet 1200 Linear Feet 400

No Lines 3 Trench Width 36" Trench Depth 18-24" Gravel Depth 12"

☑ New System ☐ Repair System Type: I II III IV V VI

System Description: gravity conventional

Repair System Description: same

Maintenance Agreement Required: ☐ Yes ☑ No

☑ House/Mod. Home No. Bedrooms 3 Garbage Disposal: ☐ Yes ☑ No

☐ Mobile Home No. Bathrooms 2 Auto. Dishwasher: ☑ Yes ☐ No


☐ Business No. Employees Auto. Washing Machine: ☑ Yes ☐ No

☐ Other Other

☐ Slab ☑ Crawl Space ☐ Basement w/plumbing ☐ Basement wo/plumbing

Comments Septic contractor note trench bottom depth of 18-24". Follow contour. Need to place extra cover at end of lines where shallow.

INITIAL SITE SKETCH

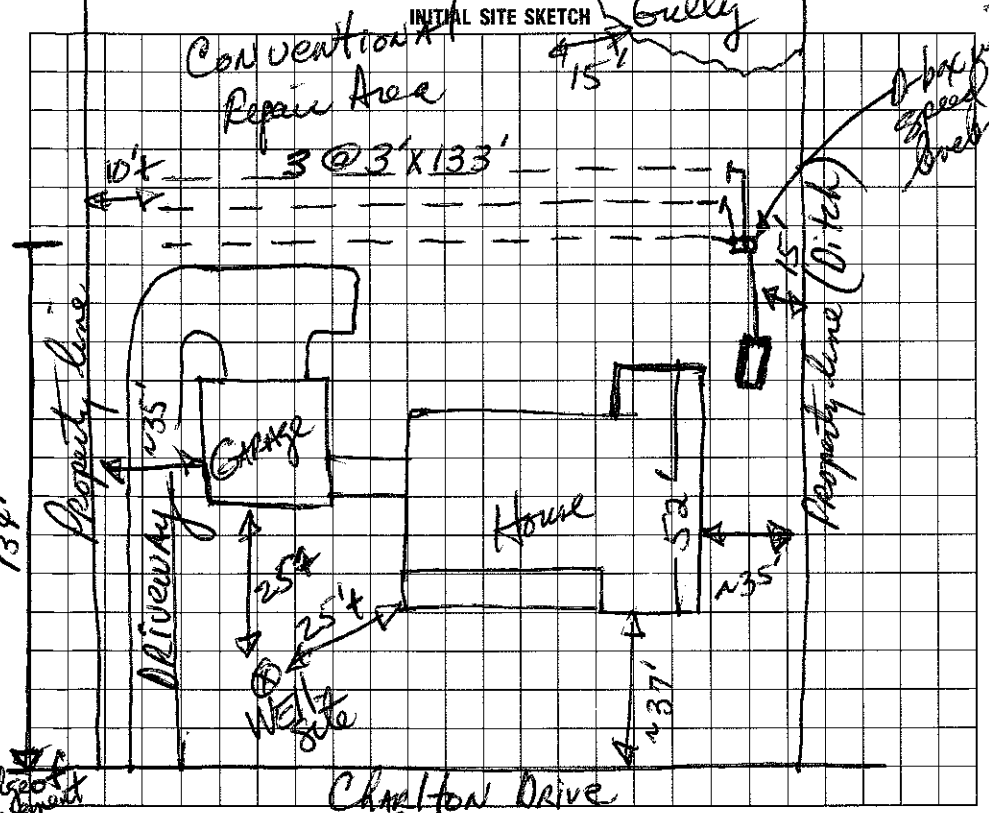


AS BUILT SKETCH

As shown on I.P.

I understand that this permit can be suspended or revoked if any false information is supplied toward securing the permit/any unauthorized changes are made to the site/any unauthorized changes are made in the installation of the system. Improvement Permit is valid for 60 months from date of issuance.

Signed X

Improvement Permit by: Jack R. Hinson, RS date 8/10/93

Existing System Inspection by: date

Installed by: Kelly Parker

Certificate of Completion by: Jack R. Hinson, RS date 8/13/93

Operation Permit by: date

HEALTH DEPT. COPY: WHITE INSPECTION COPY (FINAL): GREEN OWNER COPY (FINAL): YELLOW INSPECTION COPY (INITIAL): PINK OWNER COPY (INITIAL): GOLD