IREDELL COUNTY HEALTH DEPARTMENT

Authorization to Construct

130

STATESVILLE 704-878-5305 MOORESVILLE 704-664-5281

IMPROVEMENT PERMIT / ~~CERTIFICATE OF COMPLETION~~ / OPERATION PERMIT / EXISTING SYSTEM INSPECTION

PROPERTY DESCRIPTION NO. 20- 23301 DATE 5/28/96 TAX MAP NO. 2K-2-4-5 4647 10 6265 Watershed: ☑ Yes ☐ No

OWNER OR CONTRACTOR Chris & Lori Stenger PHONE: Business _____ Home 533-1668

ADDRESS 8030 Ebenezer Emma Dr. Charlotte NC 28215

LOCATION Brawley School - TL Farmstead Estates - Lot on Rt after pond in sharp curve

SUBDIVISION Farmstead BLOCK / SECTION _____ LOT 41 LOT AREA 21,750 ft² SITE CLASS. PS DESIGN FLOW 360 gpd L.T.A.R. .3 gpd/ft²

Septic Tank: 1000 Gallons; STB 825 Date 9/13/98

Pump Tank: 1000 Gallons; PT 47 Date 9/15/98

Pump Make: HYDRONIC Model SK50 Serial No. _____

Nitrification Field: No Fields 1 Square Feet 900 Linear Feet 300

No Lines 5 Trench Width 36" Max Trench Bottom Depth 24-30" Gravel Depth N/A

☑ New System ☐ Repair System Type: I, II, (III), IV, V, VI

System Description: Pump Chamber

Repair System Description: Pump Panel

Maintenance Agreement Required: ☐ Yes ☑ No

☑ House/Mod. Home No. Bedrooms 3

☐ Mobile Home No. Bathrooms 2

☐ Business No. Employees _____

☐ Other _____

☐ Slab ☐ Crawl Space ☐ Basement w/plumbing ☑ Basement wo/plumbing


Water Supply: ☑ Individual ☐ Community ☐ Public

Comments:


Comments:

1"=50'

INITIAL SITE SKETCH

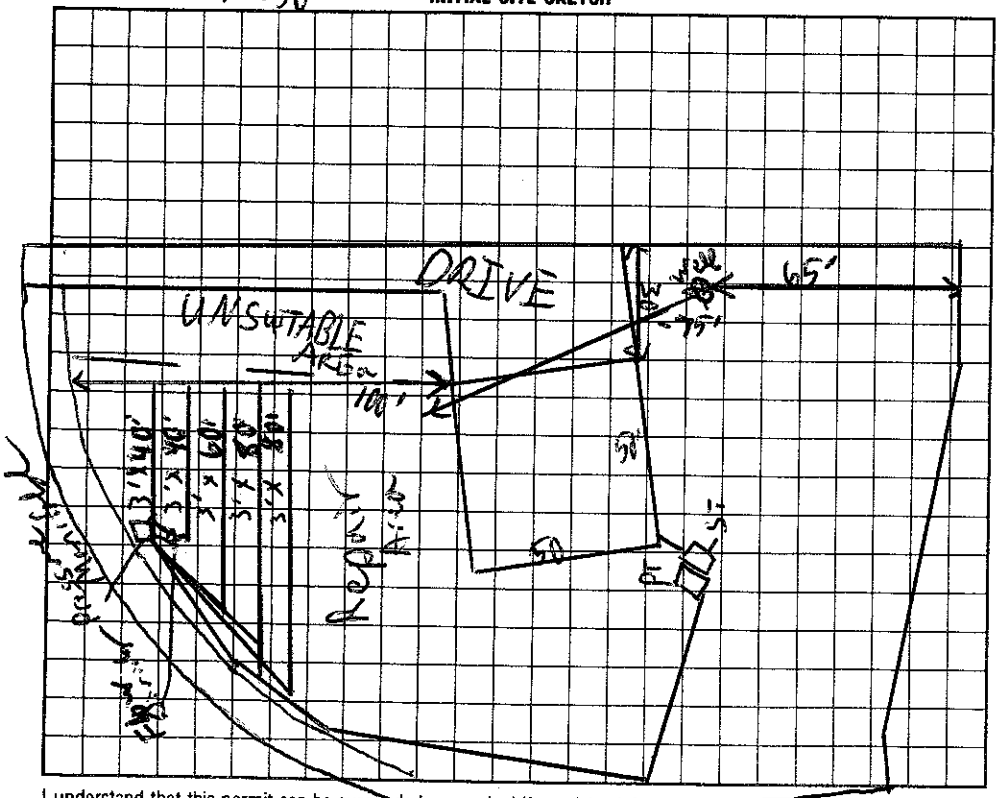

AS BUILT SKETCH

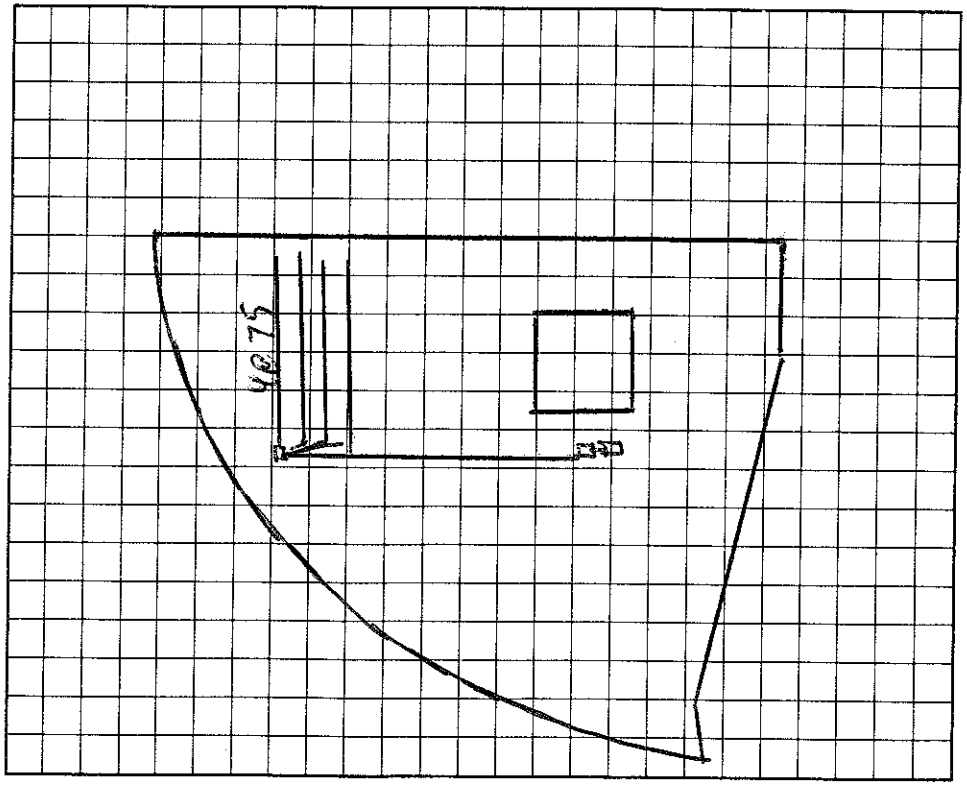

I understand that this permit can be suspended or revoked if any false information is supplied toward securing the permit/any unauthorized changes are made to the site/any unauthorized changes are made in the installation of the system.

Signed: _____

Improvement Permit by: C. Bailey Tatum EHSS date 5/28/96

Existing System Inspection by: C. Bailey Tatum EHSS date 5/28/96

Installed by: K & K GRADING

Certificate of Completion by: C. Bailey Tatum EHSS date 2/11/99

Operation Permit by: C. Bailey Tatum EHSS date 2/11/99

HEALTH DEPT. COPY: WHITE INSPECTION COPY (FINAL): GREEN OWNER COPY (FINAL): YELLOW INSPECTION COPY (INITIAL): PINK OWNER COPY (INITIAL): GOLD

Authorization to Construct is valid for 60 months from issue date