IREDELL COUNTY HEALTH DEPARTMENT

STATESVILLE 704-878-5305 MOORESVILLE 704-664-5281

IMPROVEMENT PERMIT / CERTIFICATE OF COMPLETION / OPERATION PERMIT / EXISTING SYSTEM INSPECTIO

PROPERTY DESCRIPTION NO. 17745 DATE Feb 2, '94 TAX MAP NO. 2K 22A 25/26 4647202067 Watershed: ☑ Yes ☐ No

OWNER OR CONTRACTOR Steve Gagel PHONE: Business 664-6066 Home

ADDRESS Rt 6 Box 179-G Mooresville

LOCATION 1190 past 206 Mart H Tr Homestead Ln. T/L Footbridge At End

SUBDIVISION Homestead BLOCK / SECTION LOT 61962 LOT AREA 1Ac+ SITE CLASS PS DESIGN FLOW 360gpd L.T.A.R. .3

Septic Tank: 1000 Gallons; STB 794 Bellinger Date 7-2-94

Pump Tank: 1000 Gallons; PT 27 Bellinger Date 5-30-94

Pump Make: Goulds Model WE05H Serial No. F942613

Nitrification Field: No Fields 1 Square Feet 1200 Linear Feet 400

No Lines 3 Trench Width 36" Max Trench Bottom Depth 36" Gravel Depth 12"

☑ New System ☐ Repair System Type: I, II, (III) IV, V, VI

System Description: pumped conventional

Repair System Description: Stone

Maintenance Agreement Required: ☐ Yes ☑ No

☐ House/Mod. Home No. Bedrooms 3

☐ Mobile Home No. Bathrooms 3½

☐ Business No. Employees

☐ Other


☐ Slab ☐ Crawl Space ☑ Basement w/plumbing ☐ Basement wo/plumbing

Water Supply: ☑ Individual ☐ Community ☐ Public

Comments: Dose 200 gal per 2 minute cycle
Pump Specs: 30 gal/min At Approx 24' head

Comments:

INITIAL SITE SKETCH

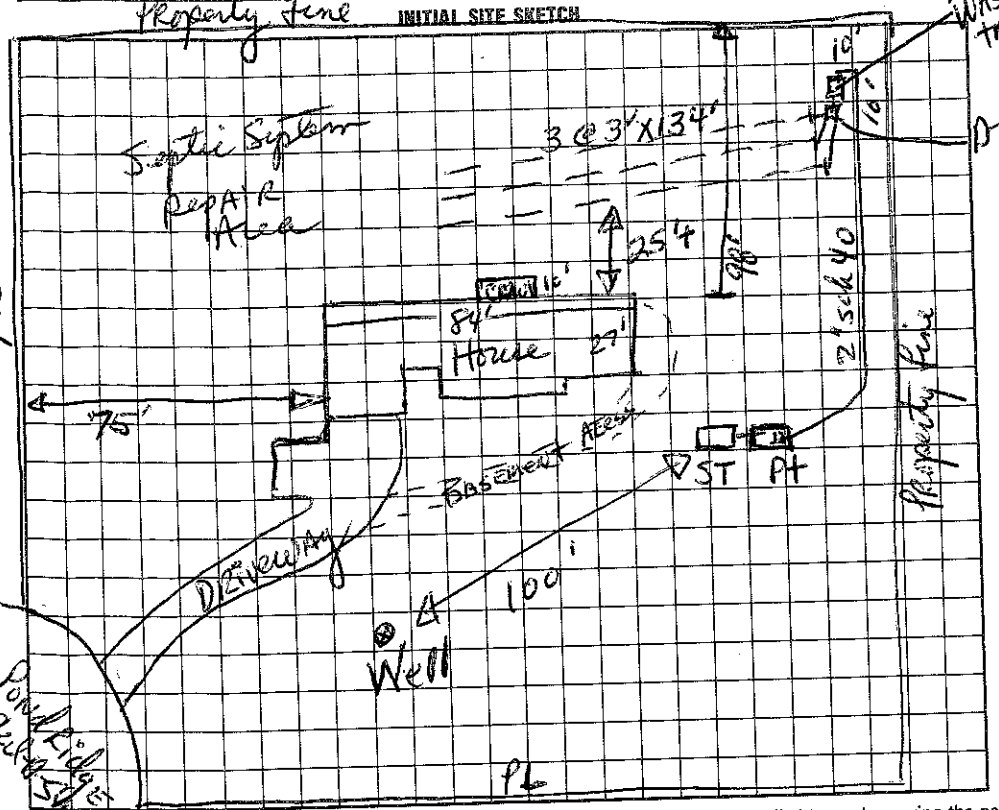

AS BUILT SKETCH

Installed essentially as shown.

I understand that this permit can be suspended or revoked if any false information is supplied toward securing the permit/any unauthorized changes are made to the site/any unauthorized changes are made in the installation of the system. Improvement Permit is valid for 60 months from date of issuance.

Signed: X Steve Gagel

Improvement Permit by: Harold R Johnson RS date 2-2-94

date

Installed by:

Certificate of Completion by: Wesley Sparks RS. date 10/11/94

Operation Permit by: date

INSPECTION COPY (FINAL): GREEN OWNER COPY (FINAL): YELLOW INSPECTION COPY (INITIAL): PINK OWNER COPY (INITIAL): GOLD