IREDELL COUNTY HEALTH DEPARTMENT

STATESVILLE 704-878-5305 MOORESVILLE 704-664-5281

IMPROVEMENT PERMIT / AUTHORIZATION TO CONSTRUCT / OPERATION PERMIT / EXISTING SYSTEM INSPECTION

PERMIT# 12245 PIN# 4646-24-4611.42 4647-20-7293 DATE 12/15/05

OWNER OR CONTRACTOR Ryan Homes PHONE: Business Home

ADDRESS 9920 Kincey Ave. #110 Huntersville NC 28078

LOCATION 150 w, TL Williamson, TR Sandown TR Eclipse on Rt near End

SUBDIVISION Est. @ Sandown BLOCK / SECTION 3 LOT 42 LOT AREA 0.644C SITE CLASS PS DESIGN FLOW 480 L.T.A.R. 0.3

Septic Tank: 1000 Gallons; STB 794 Date 3-28-06

Pump Tank: ~~1000~~ Gallons; PT Date

Pump Make: Model Serial No.

Nitrification Field: No Fields 1 Square Feet 1200 Linear Feet 400

No Lines 4 or 5 Trench Width 36 Max Trench Bottom Depth 36" Gravel Depth —

☒ New System ☐ Repair System Type: I, II, III, IV, V, VI

System Description: Pump 25% Reduction

Repair System Description: LP Pond Block

Maintenance Agreement Required: ☐ Yes ☒ No

☒ House/Mod. Home No. Bedrooms 4

☐ Mobile Home No. Bathrooms

☐ Business No. Employees

☐ Other

☐ Slab ☒ Crawl Space ☐ Basement w/plumbing ☐ Basement wo/plumbing


Water Supply: ☐ Individual ☐ Public ☒ Community

Comments:/Conditions:


1"=50'

Comments:/Conditions: 5/2/06 Spoke with Installer, okay to install as Gravity.

INITIAL SITE SKETCH

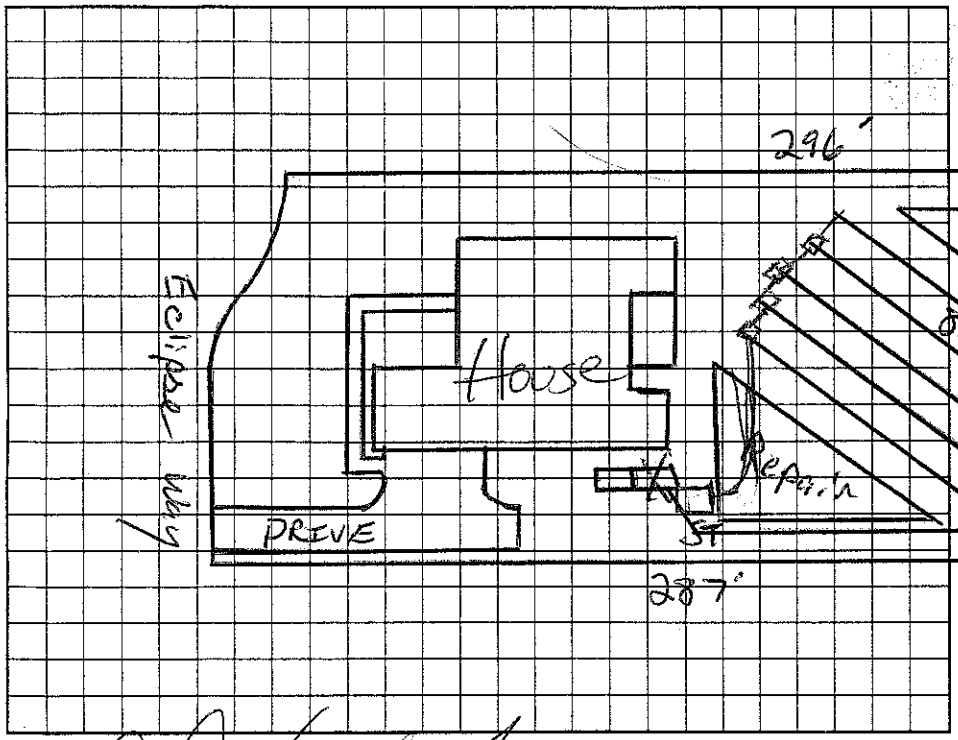

AS BUILT SKETCH

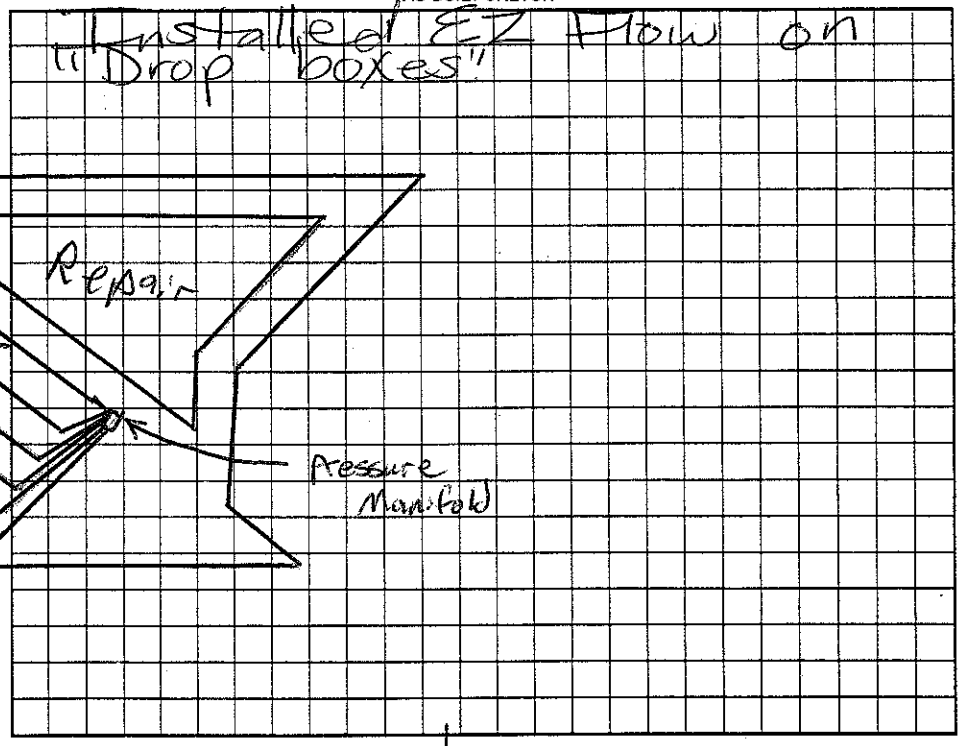

Permit can be suspended or revoked if any false information is supplied toward securing the permit/any unauthorized changes are made to the site/any unauthorized changes are made in the installation of the system. Improvement Permit with plat valid without expiration. Improvement Permit with site plan valid for sixty months. Authorization to Construct is valid for a period equal to that of Improvement Permit – not to exceed sixty months.

Signed: date 12/21/05 Installed by: R&T RS

Improvement Permit by: RS date 12/15/05 Operation Permit by: date 5/3/06

Authorization to Construct by: RS date 12/15/05 Existing System Inspection by: date

HEALTH DEPT COPY: WHITE OWNER COPY (FINAL): YELLOW OWNER COPY (INITIAL): PINK