IREDELL COUNTY HEALTH DEPARTMENT

STATESVILLE 704-878-5305 MOORESVILLE 704-664-5281

IMPROVEMENT PERMIT / AUTHORIZATION TO CONSTRUCT / OPERATION PERMIT / EXISTING SYSTEM INSPECTION

PERMIT# 5676/082798 PIN# 4647511643 / 4647323395 DATE 6-30-99

OWNER OR CONTRACTOR Brotherton Const PHONE: Business _____ Home 663-3594

ADDRESS 457 Brawley School Rd

LOCATION 457 Brawley School Rd

SUBDIVISION — BLOCK / SECTION — LOT —2#3 LOT AREA 95 AC SITE CLASS. PS DESIGN FLOW 360 L.T.A.R. .3

Septic Tank: 1000 Gallons; STB 794 Date 3-13-00
Pump Tank: _____ Gallons; PT _____ Date _____
Pump Make: _____ Model _____ Serial No. _____
Nitrification Field: No Fields 4 Square Feet 1200 Linear Feet 400
No Lines 4 @ 100 Trench Width 36 Max Trench Bottom Depth 36


~~New System~~ ☐ Repair System Type: (II) III, IV, V, VI
System Description: Grav. / Conv.
Repair System Description: Same
Maintenance Agreement Required: ☐ Yes ~~No~~

~~House/Mod. Home~~ No. Bedrooms 3
☐ Mobile Home No. Bathrooms 2
☐ Business No. Employees ____
☐ Other _____

Water Supply: ~~Individual~~ ☐ Public ☐ Community

Gravel Depth 12 ☐ Slab ~~Crawl Space~~ ☐ Basement w/plumbing ☐ Basement wo/plumbing

Comments/Conditions: No 4 to Scale

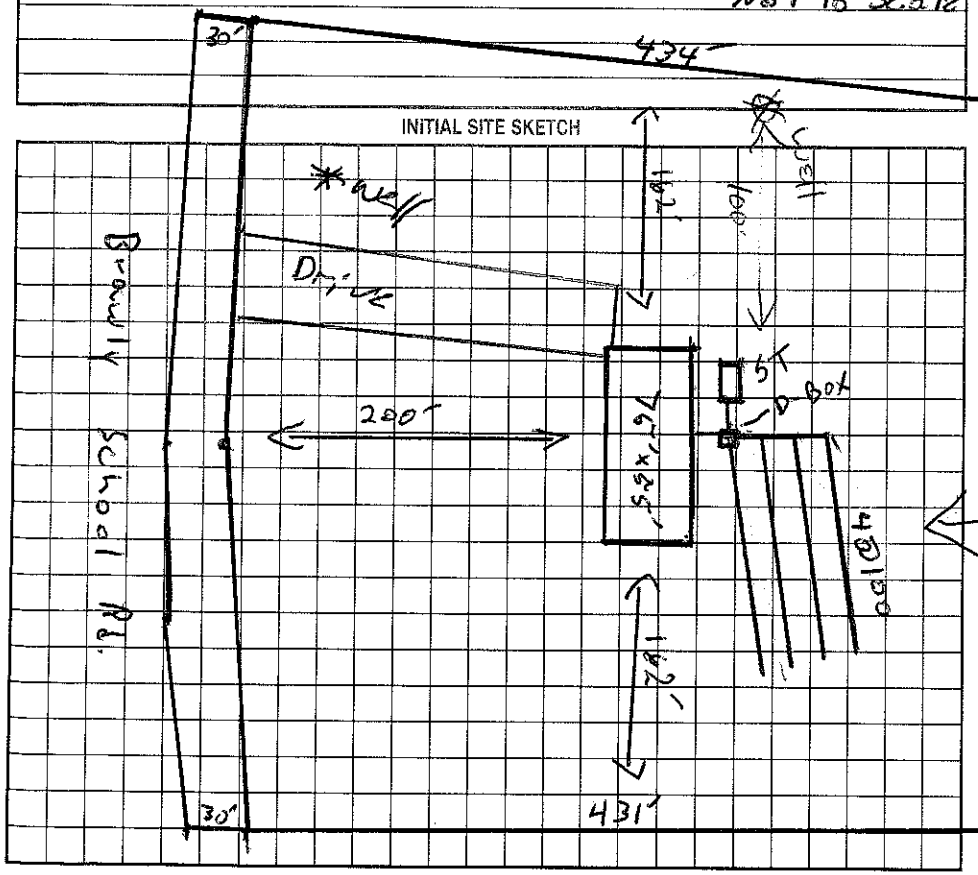

Comments/Conditions: 60-70' btw ST & D-Box risers
filter installed

AS BUILT SKETCH

Moved Drainfield back

Permit can be suspended or revoked if any false information is supplied toward securing the permit/any unauthorized changes are made to the site/any unauthorized changes are made in the installation of the system. Improvement Permit with plat valid without expiration. Improvement Permit with site plan valid for sixty months. Authorization to Construct is valid for a period equal to that of Improvement Permit – not to exceed sixty months.

Signed: _____ date 7-2-99 Installed by: E.T. Ervin

Improvement Permit by: Jeff Mozen date 6-30-99 Operation Permit by: Maria H. Dotson RS date 5/4/2000

Authorization to Construct by: Jeff Mozen date 6-30-99 Existing System Inspection by: _____ date _____

HEALTH DEPT. COPY: WHITE OWNER COPY (FINAL): YELLOW OWNER COPY (INITIAL): PINK