4647420775

IREDELL COUNTY HEALTH DEPARTMENT

STATESVILLE 704-878-5305 MOORESVILLE 704-664-5281

IMPROVEMENT PERMIT / CERTIFICATE OF COMPLETION / OPERATION PERMIT / EXISTING SYSTEM INSPECTIO

PROPERTY DESCRIPTION NO 2496 DATE Oct 20, '93 TAX MAP NO. 2JA60 Watershed: ☑ Yes ☐ No

OWNER OR CONTRACTOR Teresa Passantino PHONE: Business _____ Home 664-6348 LAKE NORMAN

ADDRESS Rt 6 Box 392, Mooresville

LOCATION ISDW, TL 1109, TL 1100 ¼ mile on Right

SUBDIVISION _____ BLOCK / SECTION _____ LOT _____ LOT AREA 1.968 SITE CLASS. PS DESIGN FLOW 360gpd L.T.A.R. .4

Septic Tank: 1000 Gallons; STB 825 RST Date 2-27-94

Pump Tank: _____ Gallons; PT _____ Date _____

Pump Make: _____ Model _____ Serial No. _____

Nitrification Field: No Fields 1 Square Feet 900 Linear Feet 300

No Lines 3 Trench Width 36" Max Trench Bottom Depth 36" Gravel Depth 12"

☑ New System ☐ Repair System Type: I, II, III, IV, V, VI

System Description: gravity conventional

Repair System Description: same

Maintenance Agreement Required: ☐ Yes ☑ No

☑ House/Mod. Home No. Bedrooms 3

☐ Mobile Home No. Bathrooms 3

☐ Business No. Employees ____

☐ Other _____


☐ Slab ☑ Crawl Space ☐ Basement w/plumbing ☐ Basement wo/plumbing

Water Supply: ☑ Individual ☐ Community ☐ Public

Comments: Follow contour.

Comments:

INITIAL SITE SKETCH

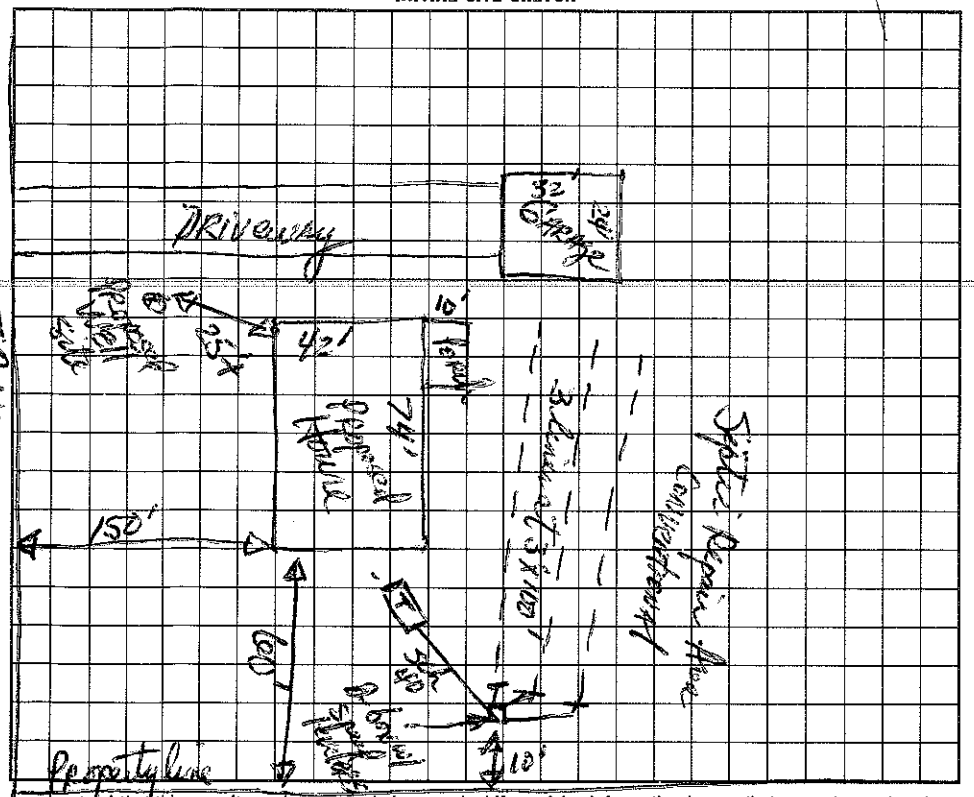

AS BUILT SKETCH

Substantially as shown on initial sketch

I understand that this permit can be suspended or revoked if any false information is supplied toward securing the permit/any unauthorized changes are made to the site/any unauthorized changes are made in the installation of the system. Improvement Permit is valid for 60 months from date of issuance.

Signed: J W Dawson Jr

Improvement Permit by: Jack R Henson, RS date 10/20/93

Existing System Inspection by: _____ date _____

Installed by: Delbert Bostian

Certificate of Completion by: David R Henson RS date 4/26/94

Operation Permit by: _____ date _____

HEALTH DEPT. COPY: WHITE INSPECTION COPY (FINAL): GREEN OWNER COPY (FINAL): YELLOW INSPECTION COPY (INITIAL): PINK OWNER COPY (INITIAL): GOLD