IREDELL COUNTY HEALTH DEPARTMENT

Expansion over 365.00
STATESVILLE 704-878-5305

4647 42 9361
MOORESVILLE 704-664-5281

IMPROVEMENT PERMIT / AUTHORIZATION TO CONSTRUCT / OPERATION PERMIT / EXISTING SYSTEM INSPECTION

PERMIT # 151140 PIN # 4647520421.000 DATE 12/5/08

OWNER or APPLICANT Mike Cashion PHONE: Business 704 875 4014 Home: 704 664-7380

OWNER or APPLICANT ADDRESS 489 Brawley Schl. Rd.

LOCATION / DIRECTIONS Brawley School Rd. Cross 77 Cross small bridge 3rd House on Left

SUBDIVISION N/A BLOCK / SECTION LOT # LOT AREA 1.74 DESIGN FLOW 240 L.T.A.R. Exis

Septic Tank New 1000 Gallons: STB 32 Date 7-17-09
Pump Tank Gallons: P T Date
Pump Make Model Serial #
Nitrification Field No Fields 1 No Lines 4 Linear Feet Exis 200'
Trench Width Exis Max. Trench Bottom Depth Exis Gravel Depth N/A

☐ New System ☐ Repair ☒ Expansion System Type I II (III) IV V VI
System Description: New Septic Tank
Repair System Description: N/A
Maintenance Agreement Required ☐ YES ☑ NO
☑ GRAVITY ☐ PRESSURE Supply


☑ Residence No. Bedrooms 2
☐ Business No. Persons
☐ Other No. Employees
☐ Slab ☐ Crawl Space
☐ Basement w/plumbing ☐ Basement w/o plumbing

Water Supply
☑ Private Exis
☐ Public
☐ Community


Comments / Conditions This is a Brawley School Rd. widening Project
Exis House will be moved ≈65' back
Install new 1000 gal septic Tank to Exis 200' drainfield. connect
1"=60'

Comments / Conditions * Pipe under Drive must be Sch 80 or sleeved in iron or buried >30" deep.
* Exis S/T To be abandoned by filling in & crushing in place.

INITIAL SITE SKETCH

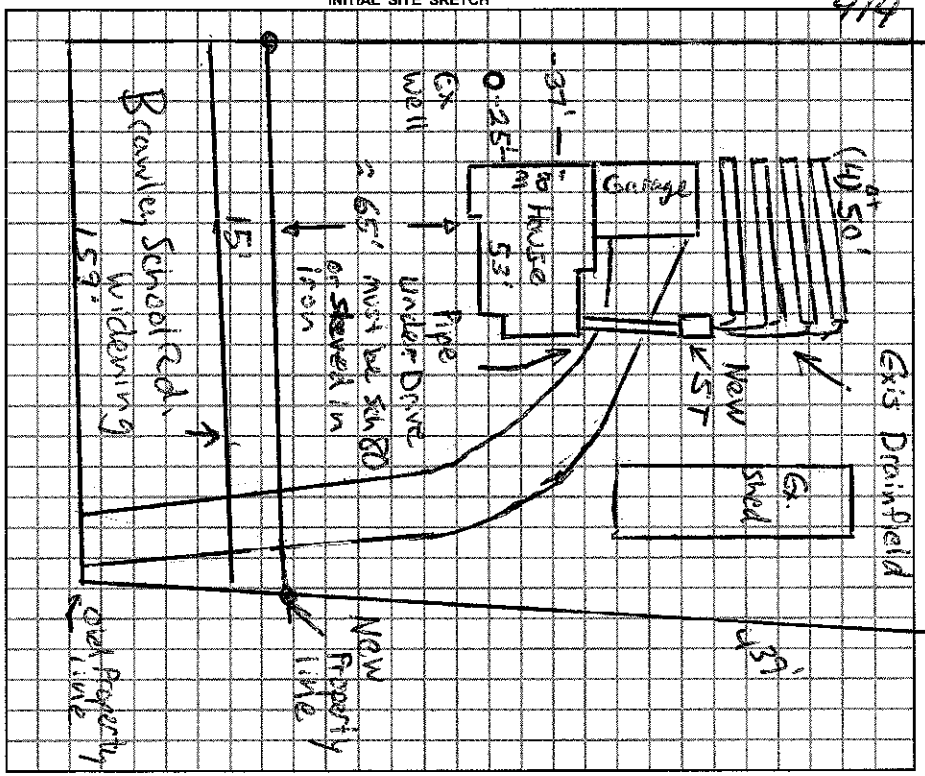

AS BUILT SKETCH

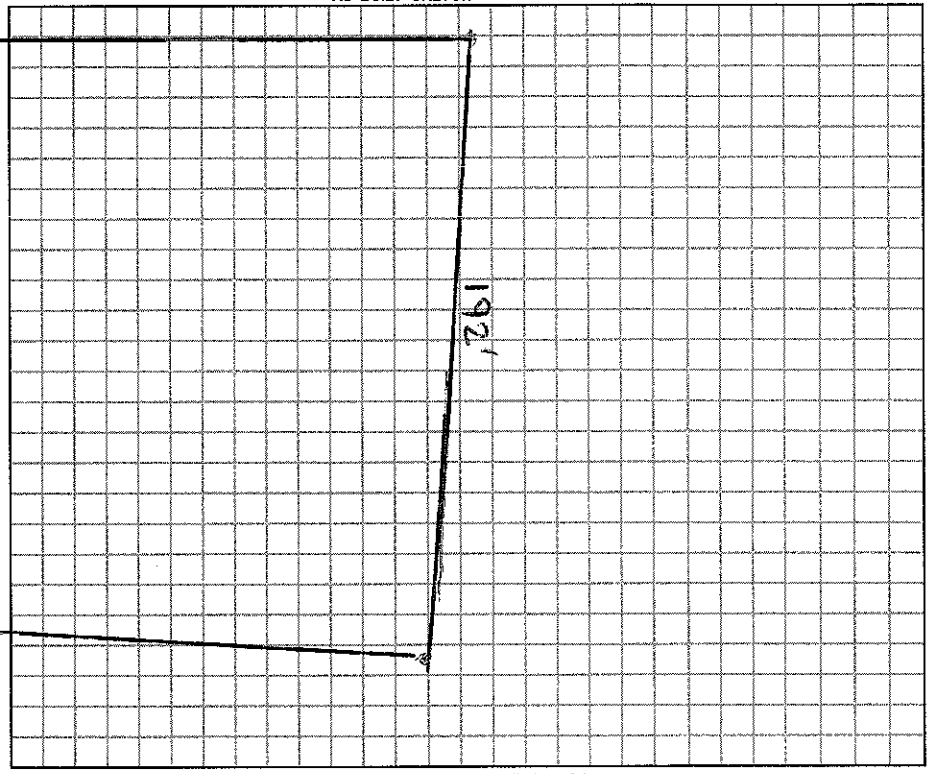

Permit can be suspended or revoked if any false information is supplied toward securing the permit / any unauthorized changes are made to the site / any unauthorized changes are made in the installation of the system.

☐ *IMPROVEMENT PERMIT w / plat valid without expiration.* ☑ *IMPROVEMENT PERMIT w / site plan valid for 60 mos.* ☑ *AUTHORIZATION TO CONSTRUCT valid for period equal to IMPROVEMENT PERMIT-not to exceed 60 mo.*

Owner / Applicant Signature: Mike Date 12-5-08
Improvement Permit by: Anthony Cohen Jr. R.S. Date 12/5/08
Authorzation to Construct by: Anthony Cohen Jr. R.S. Date 12/5/08

YOU SHOULD CONTACT A LOCATOR SERVICE PRIOR TO ANY EXCAVATION.

Installed by: MIKE CASHION (OWNER)
Operation Permit by: REHS Date: 5-17-10
Existing System Inspected by: Date:

WHITE COPY Environmental Health YELLOW COPY (Final) Owner / Applicant PINK COPY (Initial) Owner / Applicant