164317

IREDELL COUNTY HEALTH DEPARTMENT

STATESVILLE 704-878-5305 MOORESVILLE 704-664-5281

IMPROVEMENT PERMIT / AUTHORIZATION TO CONSTRUCT / OPERATION PERMIT / EXISTING SYSTEM INSPECTION

PERMIT# 5676/082798 PIN# ~~4647751643~~ 4647523177 DATE 6-30-99

OWNER OR CONTRACTOR Brotherton Const./Roderick Kistler PHONE: Business _____ Home 662-3574

ADDRESS 457 Brawley School Rd

LOCATION 457 Brawley School Rd

SUBDIVISION — BLOCK / SECTION — LOT —2+3 LOT AREA 95 AC SITE CLASS. PS DESIGN FLOW 360 L.T.A.R. .3

Septic Tank: 1000 Gallons; STB 794 Date 3-13-00

Pump Tank: _____ Gallons; PT _____ Date _____

Pump Make: _____ Model _____ Serial No. _____

Nitrification Field: No Fields 1 Square Feet 1200 Linear Feet 400

No Lines 4 @ 100 Trench Width 36 Max Trench Bottom Depth 36 Gravel Depth 12

[X] New System [ ] Repair System Type: [II] III, IV, V, VI

System Description: Grav./Conv.

Repair System Description: Same

Maintenance Agreement Required: [ ] Yes [X] No

[X] House/Mod. Home No. Bedrooms 3

[ ] Mobile Home No. Bathrooms 2

[ ] Business No. Employees ____

[ ] Other _____


[ ] Slab [X] Crawl Space [ ] Basement w/plumbing [ ] Basement wo/plumbing

Water Supply: [X] Individual [ ] Public [ ] Community

Comments/Conditions:

Not to Scale


INITIAL SITE SKETCH

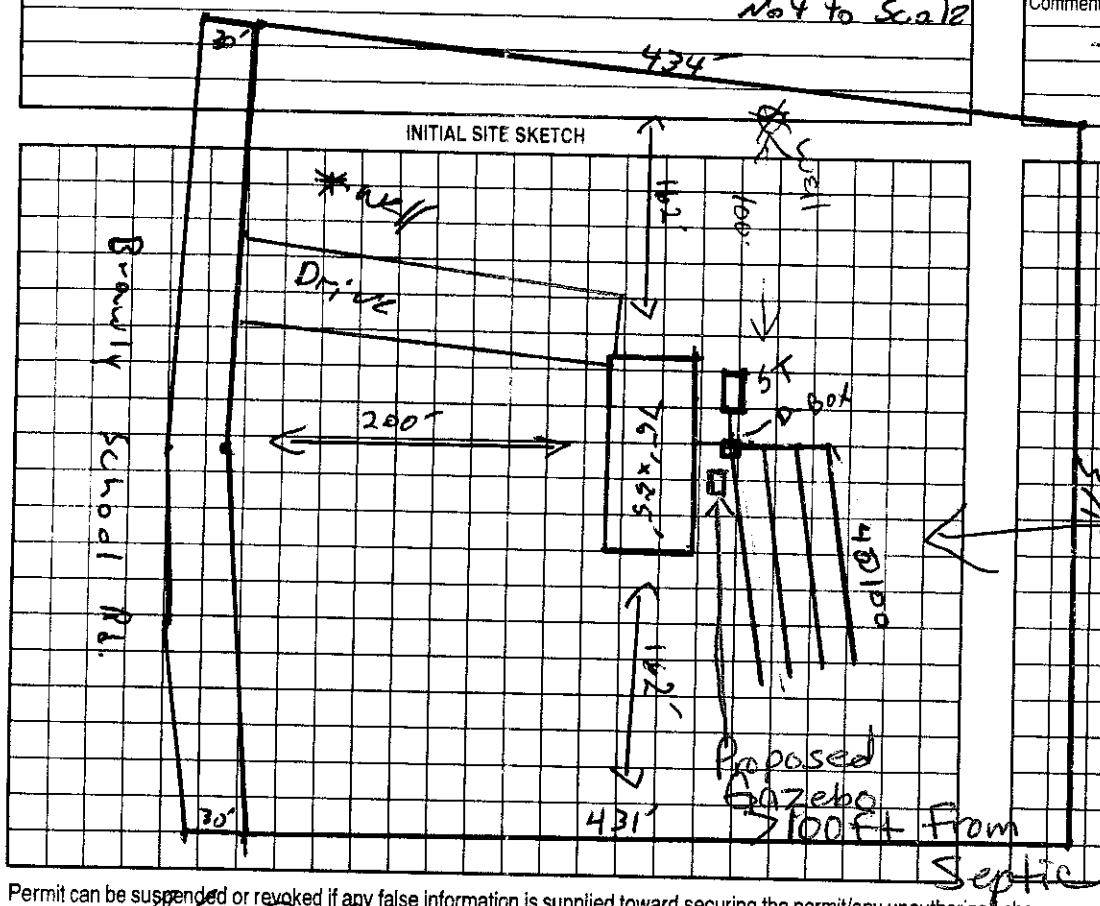

Comments/Conditions: 60-70' btw ST & D-Box risered

Filter installed

AS BUILT SKETCH

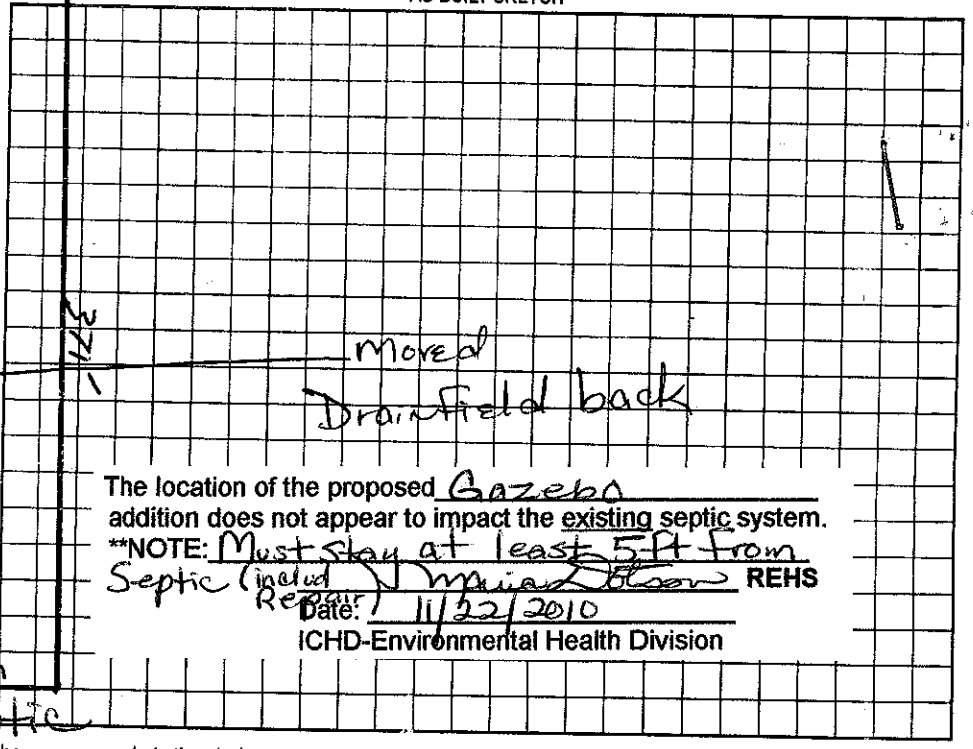

The location of the proposed Gazebo addition does not appear to impact the existing septic system.

**NOTE: Must stay at least 5-ft from Septic (including Repair)

Maria Dotson REHS

Date: 11/22/2010

ICHD-Environmental Health Division

Permit can be suspended or revoked if any false information is supplied toward securing the permit/any unauthorized changes are made to the site/any unauthorized changes are made in the installation of the system. Improvement Permit with plat valid without expiration. Improvement Permit with site plan valid for sixty months. Authorization to Construct is valid for a period equal to that of Improvement Permit – not to exceed sixty months.

Signed: _____ date 7-2-99

Improvement Permit by: Jeff Mozden date 6-30-99

Authorization to Construct by: Jeff Mozden date 6-30-99

Installed by: E.J. Ervin

Operation Permit by: Maria Dotson RS date 5/4/2000

Existing System Inspection by: _____ date _____

HEALTH DEPT. COPY: WHITE OWNER COPY (FINAL): YELLOW OWNER COPY (INITIAL): PINK