# IREDELL COUNTY HEALTH DEPARTMENT

STATESVILLE 704-878-5305 MOORESVILLE 704-664-5281

## IMPROVEMENT PERMIT / AUTHORIZATION TO CONSTRUCT / OPERATION PERMIT / EXISTING SYSTEM INSPECTION

PERMIT# 92985 PIN# 4679029878 PT DATE 1/10/01

OWNER OR CONTRACTOR BEECHWOOD PARTNERS PHONE: Business 664-9080 Home

ADDRESS 225 ROLLING HILLS RD MOORESVILLE

LOCATION 801 N - TL TRIPLETT - TL MALLARD WOOD - ON RT

SUBDIVISION BEECHWOOD EST. BLOCK / SECTION LOT 8 LOT AREA .78 AC SITE CLASS. RS DESIGN FLOW 300 GPD L.T.A.R. .30 PD/FT²

Septic Tank: 1000 Gallons; STB Date

Pump Tank: Gallons; PT Date

Pump Make: Model Serial No.

Nitrification Field: No Fields 1 Square Feet 900 Linear Feet 300

No Lines 3 @ 100' Trench Width 36" Max Trench Bottom Depth 24" Gravel Depth N/A

☑ New System ☐ Repair System Type: I, II, III, IV, V, VI

System Description: GRAVITY INNOVATIVE

Repair System Description: SAME

Maintenance Agreement Required: ☐ Yes ☑ No

☑ House/Mod. Home No. Bedrooms 3

☑ Mobile Home No. Bathrooms 3

☐ Business No. Employees

☐ Other


☐ Slab ☑ Crawl Space ☐ Basement w/plumbing ☐ Basement wo/plumbing

Water Supply: ☑ Individual ☐ Public ☐ Community


Comments:/Conditions:

Comments:/Conditions:

INITIAL SITE SKETCH 1" = 50'

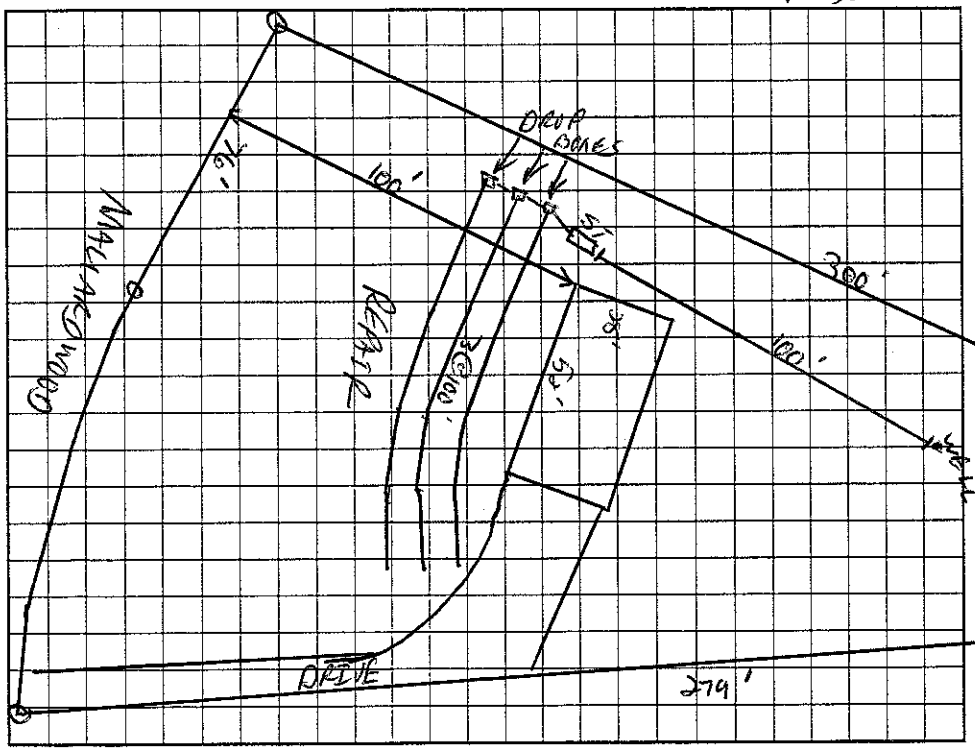


AS BUILT SKETCH

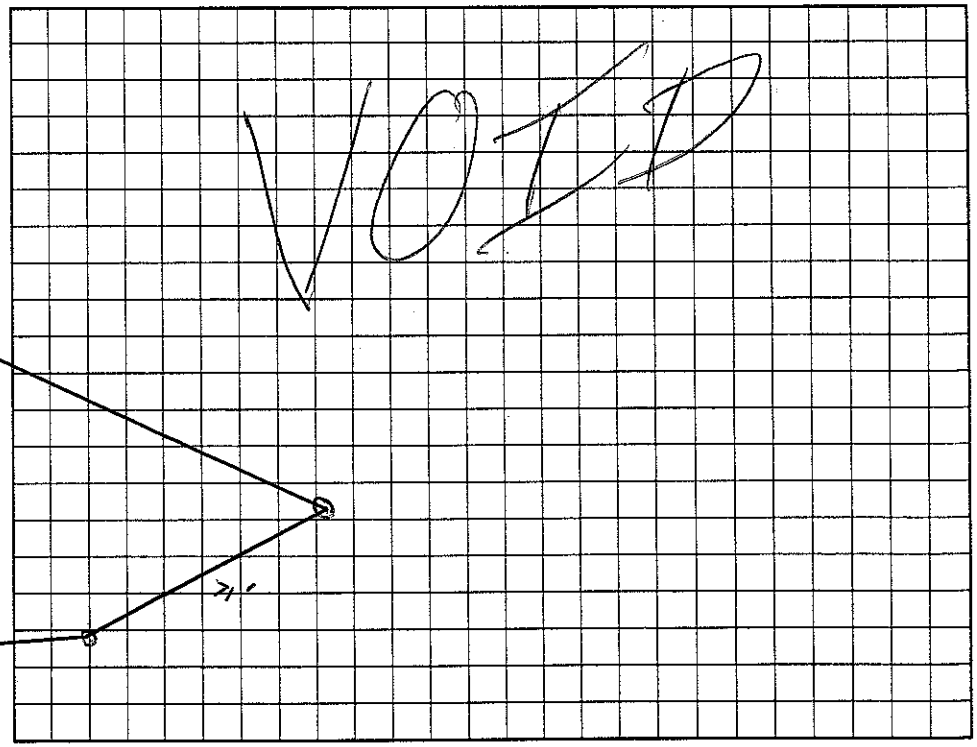


Permit can be suspended or revoked if any false information is supplied toward securing the permit/any unauthorized changes are made to the site/any unauthorized changes are made in the installation of the system. Improvement Permit with plat valid without expiration. Improvement Permit with site plan valid for sixty months. Authorization to Construct is valid for a period equal to that of Improvement Permit – not to exceed sixty months.

Signed: date 1/29/01 Installed by:

Improvement Permit by: date 1/10/01 Operation Permit by: date

Authorization to Construct by: date Existing System Inspection by: date

HEALTH DEPT. COPY: WHITE OWNER COPY (FINAL): YELLOW OWNER COPY (INITIAL): PINK