IREDELL COUNTY HEALTH DEPARTMENT

STATESVILLE 704-878-5305 — 50.00 Paid — MOORESVILLE 704-664-5281

IMPROVEMENT PERMIT / AUTHORIZATION TO CONSTRUCT / OPERATION PERMIT / EXISTING SYSTEM INSPECTION

PERMIT# 92985 — PIN# 4649-63-5242 — DATE 10/11/01

OWNER OR CONTRACTO: Thomas Fleetwood — PHONE: Business 704-662-8436 Home

ADDRESS 225 Rolling Hills Rd Mooresville NC 28115

LOCATION 801 N, Tq Tripplet, TL Mallard wood on Rt

SUBDIVISION Beach Wood Est. BLOCK / SECTION — LOT 8 — LOT AREA 0.78 AC — SITE CLASS. PS — DESIGN FLOW 480 — L.T.A.R. 0.3

Septic Tank: 1000 Gallons; STB 1012 Date 6/11/03
Pump Tank: — Gallons; PT — Date —
Pump Make: — Model — Serial No. —
Nitrification Field: No Fields 1 Square Feet 1200 Linear Feet 400
No Lines 4 @ 100' Trench Width 36" Max Trench Bottom Depth 24" Gravel Depth —

☒ New System ☐ Repair System Type: I, II, (III), IV, V, VI
System Description: Gravity 25% Reduct.
Repair System Description: same
Maintenance Agreement Required: ☐ Yes ☒ No

☐ House/Mod. Home ☒ Mobile Home ☐ Business ☐ Other
No. Bedrooms 4 No. Bathrooms 2 No. Employees —


☐ Slab ☒ Crawl Space ☐ Basement w/plumbing ☐ Basement wo/plumbing

Water Supply: ☒ Individual ☐ Public ☐ Community


Comments:/Conditions:

Comments:/Conditions:

INITIAL SITE SKETCH

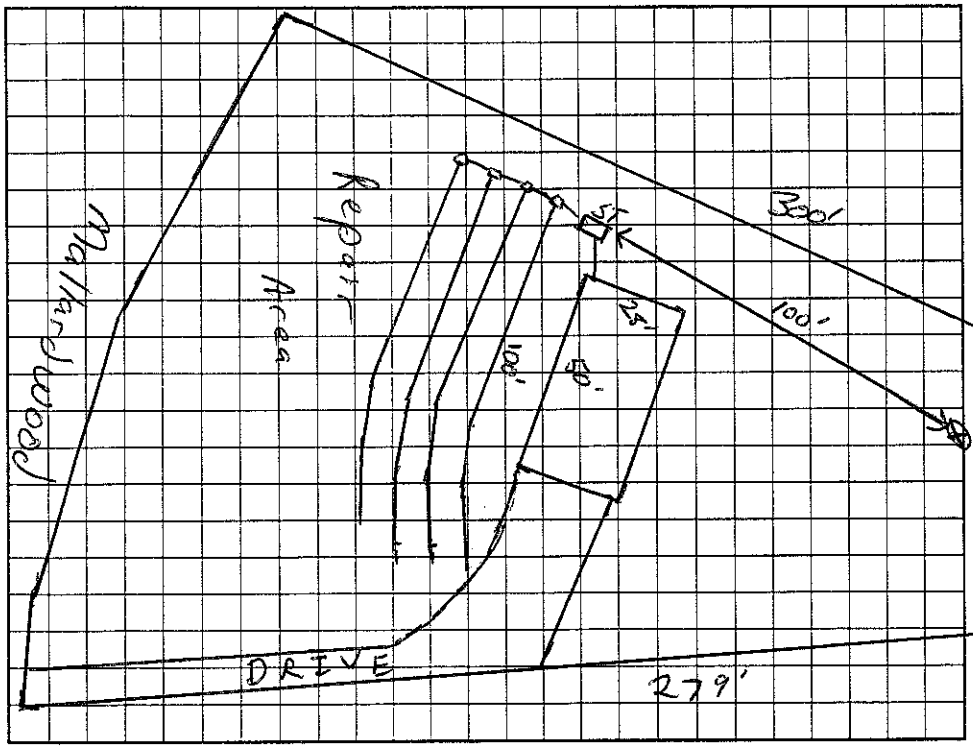

AS BUILT SKETCH

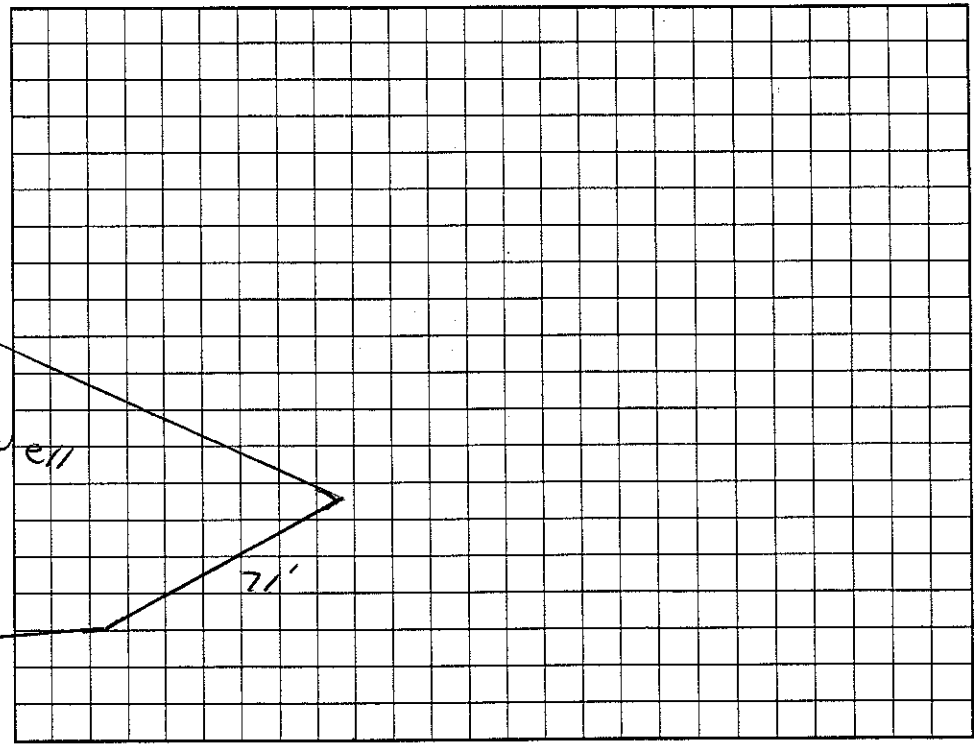

Permit can be suspended or revoked if any false information is supplied toward securing the permit/any unauthorized changes are made to the site/any unauthorized changes are made in the installation of the system. Improvement Permit with plat valid without expiration. Improvement Permit with site plan valid for sixty months. Authorization to Construct is valid for a period equal to that of Improvement Permit – not to exceed sixty months.

Signed: [signature] date 10-22-03 — Installed by: Craig Thompson

Improvement Permit by: [signature] RSF date 10/11/01 — Operation Permit by: [signature] RS date 12/10/03

Authorization to Construct by: [signature] RSF date 10/11/01 — Existing System Inspection by: — date —

HEALTH DEPT. COPY: WHITE OWNER COPY (FINAL): YELLOW OWNER COPY (INITIAL): PINK