IREDELL COUNTY HEALTH DEPARTMENT

STATESVILLE 704-878-5305 MOORESVILLE 704-664-5281

IMPROVEMENT PERMIT / AUTHORIZATION TO CONSTRUCT / OPERATION PERMIT / EXISTING SYSTEM INSPECTION

PERMIT# 092970 PIN# ~~4674-02-9878 (lot)~~ 4647-63-8761 DATE Nov. 29, 00

OWNER OR CONTRACTOR Beechwood Partners // Earnest Beatty & Paul Sprinkle PHONE: Business 646-4800 Home

ADDRESS 225 Rolling Hills Rd. Mooresville, N.C. 28117

LOCATION 801 N to TL Triplett Rd. TL Mallardwood Drive on Right

SUBDIVISION Beechwood Est. BLOCK / SECTION LOT 5 LOT AREA .75+ac SITE CLASS. PS DESIGN FLOW 360gpd L.T.A.R. .3 @ ≤ 26"

Septic Tank: 1000 Gallons; STB 1012 Date 10-20-00

Pump Tank: Gallons; PT Date

Pump Make: Model Serial No.

Nitrification Field: No Fields 1 Square Feet 1200 Linear Feet 400

No Lines 5 Trench Width 36" Max Trench Bottom Depth 26" * Gravel Depth

☑ New System ☐ Repair System Type: I, II, III, IV, V, VI

System Description: Gravity Conventional

Repair System Description: Pumped Innovative-25% Red.

Maintenance Agreement Required: ☐ Yes ☑ No

☐ House/Mod. Home No. Bedrooms 3

☑ Mobile Home OW No. Bathrooms 2

☐ Business No. Employees

☐ Other

☐ Slab ☑ Crawl Space ☐ Basement w/plumbing ☐ Basement wo/plumbing

Water Supply: ☑ Individual ☐ Public ☐ Community


Comments:/Conditions: * Ends of Laterals (esp Lowest Laterals) may be slightly deeper due to presence of old burn/hedgerow.

Comments:/Conditions: Well 100'± to Drainfield

Polylok filter installed

1" = 60'

INITIAL SITE SKETCH

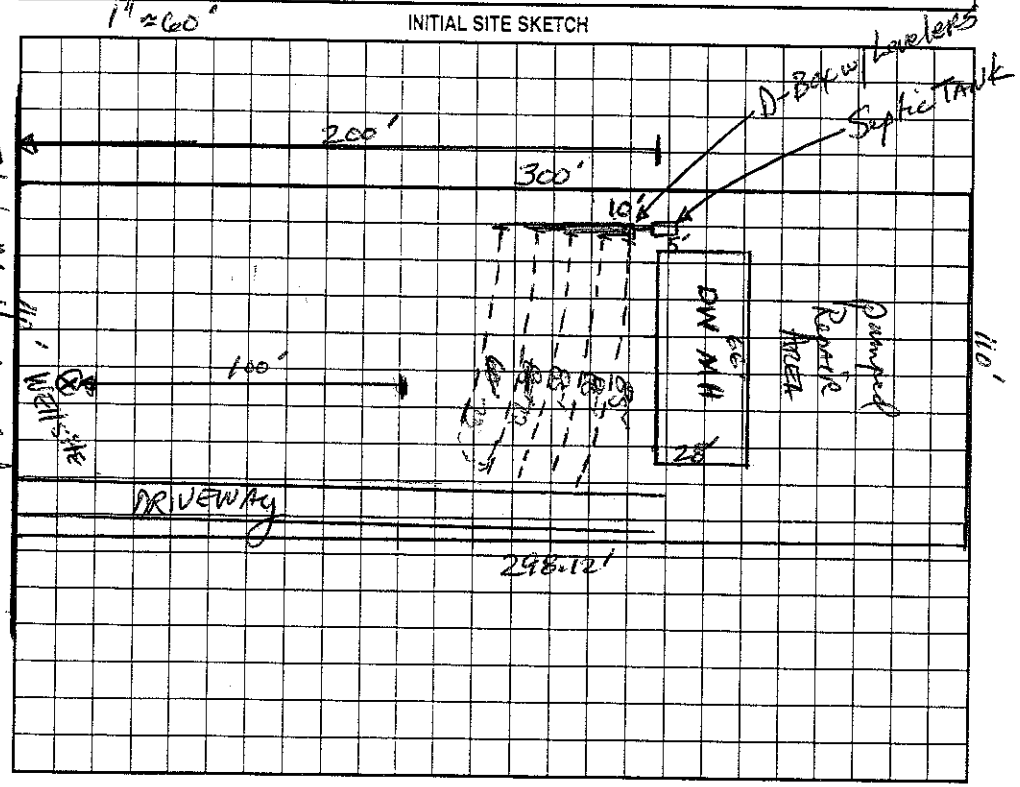

AS BUILT SKETCH

Installed As Drawn

Permit can be suspended or revoked if any false information is supplied toward securing the permit/any unauthorized changes are made to the site/any unauthorized changes are made in the installation of the system. Improvement Permit with plat valid without expiration. Improvement Permit with site plan valid for sixty months. Authorization to Construct is valid for a period equal to that of Improvement Permit – not to exceed sixty months.

Signed: Mark / Marie date 11/29/00 Installed by: A-1 Backhoe

Improvement Permit by: date 11-29-00 Operation Permit by: date 11/30/2000

Authorization to Construct by: date 11-30-00 Existing System Inspection by: date

HEALTH DEPT. COPY: WHITE OWNER COPY (FINAL): YELLOW OWNER COPY (INITIAL): PINK