4647703384

IREDELL COUNTY HEALTH DEPARTMENT

STATESVILLE 704-878-5305 MOORESVILLE 704-664-5281

IMPROVEMENT PERMIT / CERTIFICATE OF COMPLETION / OPERATION PERMIT / EXISTING SYSTEM INSPECTION

PROPERTY DESCRIPTION NO. 3503 DATE 10/18/95 TAX MAP NO. 2J 16 A4 Watershed: ☐ Yes ☒ No

OWNER OR CONTRACTOR David & Beverly Canter PHONE: Business _____ Home 664-1034

ADDRESS 131 Edgewater Dr. Mayd, NC.

LOCATION Brew. Sch. TR Gilbert Rd. TR Kittyhawk TR Plymouth Ct. ⊙ of cent end cul de sac

SUBDIVISION _____ BLOCK / SECTION _____ LOT _____ LOT AREA ~ 1.22 AC SITE CLASS. PS DESIGN FLOW 360 L.T.A.R. .3

Septic Tank: 1000 Gallons; STB 794 Date 5/21/96
Pump Tank: _____ Gallons; PT _____ Date _____
Pump Make: _____ Model _____ Serial No. _____
Nitrification Field: No Fields 1 Square Feet 1200 Linear Feet ~~300~~
No Lines 3 Trench Width 36" Max Trench Bottom Depth 30" Gravel Depth N/A

☒ New System ☐ Repair System Type: I, II, (III), IV, V, VI
System Description: GRAVITY INFILTRATOR
Repair System Description: SAME
Maintenance Agreement Required: ☐ Yes ☒ No


☒ House/Mod. Home No. Bedrooms 3
☐ Mobile Home No. Bathrooms 2.5
☐ Business No. Employees ____
☐ Other _____
☐ Slab ☒ Crawl Space ☐ Basement w/plumbing ☐ Basement wo/plumbing

Water Supply: ☒ Individual ☐ Community ☐ Public


Comments: ~~X~~ GRAVITY INFILTRATOR - 25% REDUCTION

Comments:

INITIAL SITE SKETCH 1" = 50

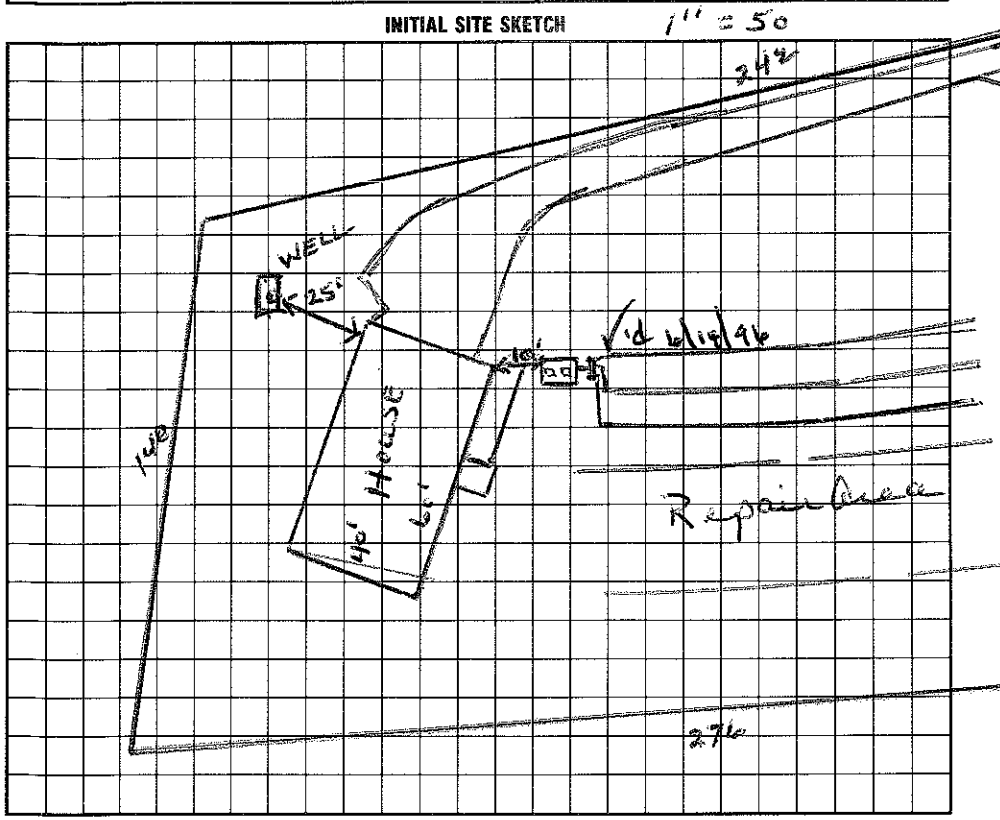

AS BUILT SKETCH

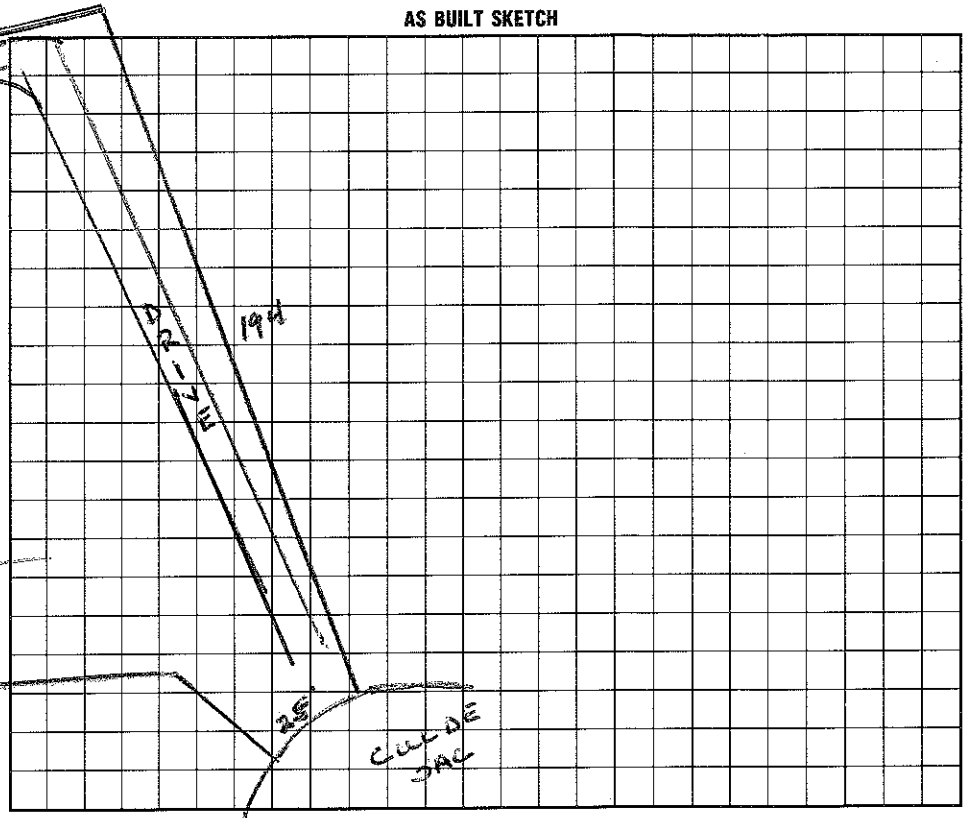

I understand that this permit can be suspended or revoked if any false information is supplied toward securing the permit/any unauthorized changes are made to the site/any unauthorized changes are made in the installation of the system.

Signed: X [signature]

Improvement Permit by: Wesley Sparks R.S. date 10/18/95

Existing System Inspection by: Authorized Agent Wesley Sparks R.S. date 10/18/95

Installed by: F J Ervin

Certificate of Completion by: _____ date _____

Operation Permit by: Wesley Sparks R.S. date 6/17/96

HEALTH DEPT. COPY: WHITE INSPECTION COPY (FINAL): GREEN OWNER COPY (FINAL): YELLOW INSPECTION COPY (INITIAL): PINK OWNER COPY (INITIAL): GOLD