IREDELL COUNTY HEALTH DEPARTMENT

STATESVILLE 704-878-5305 MOORESVILLE 704-664-5281

IMPROVEMENT PERMIT / AUTHORIZATION TO CONSTRUCT / OPERATION PERMIT / EXISTING SYSTEM INSPECTION

PERMIT# 92986 PIN# 4679 029875 PT DATE 1/6/01

OWNER OR CONTRACTOR BEECHWOOD FARMERS PHONE: Business 664-9080 Home

ADDRESS 225 ROLLING HILLS RD MOORESVILLE

LOCATION SOUTH - TL TEEPLET - TL MALLARD WOOD - ON RT

SUBDIVISION BEECHWOOD ESTS BLOCK / SECTION LOT 9 LOT AREA 1.11 SITE CLASS. B DESIGN FLOW 360GPD L.T.A.R. .30 GPD/FT²

Septic Tank: 1000 Gallons; STB Date

Pump Tank: Gallons; PT Date

Pump Make: Model Serial No.

Nitrification Field: No Fields 1 Square Feet 900 Linear Feet 300

No Lines 4 @ 75' Trench Width 36" Max Trench Bottom Depth 36" Gravel Depth N/A

☒ New System ☐ Repair System Type: I, II, III, IV, V, VI

System Description: GRAVITY INNOVATIVE

Repair System Description: SAME

Maintenance Agreement Required: ☐ Yes ☒ No

☐ House/Mod. Home No. Bedrooms 3

☒ Mobile Home No. Bathrooms 3

☐ Business No. Employees

☐ Other


☐ Slab ☐ Crawl Space ☐ Basement w/plumbing ☐ Basement wo/plumbing

Water Supply: ☒ Individual ☐ Public ☐ Community


Comments:/Conditions:

Comments:/Conditions:

INITIAL SITE SKETCH 1" = 50'

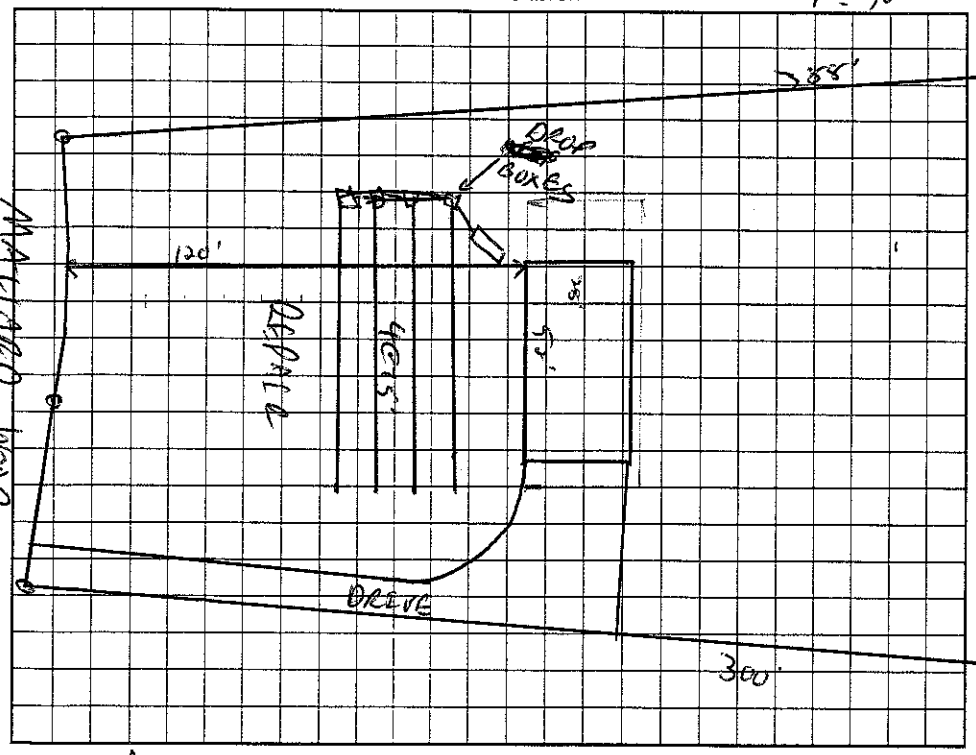

AS BUILT SKETCH

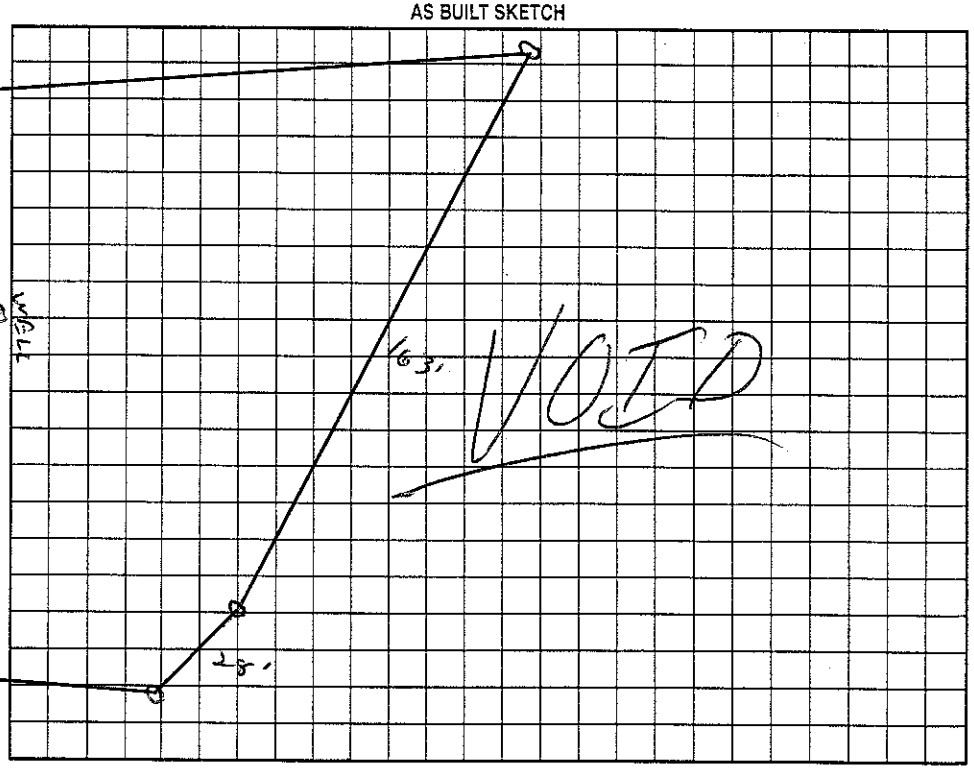

Permit can be suspended or revoked if any false information is supplied toward securing the permit/any unauthorized changes are made to the site/any unauthorized changes are made in the installation of the system. Improvement Permit with plat valid without expiration. Improvement Permit with site plan valid for sixty months. Authorization to Construct is valid for a period equal to that of Improvement Permit – not to exceed sixty months.

Signed: James E Mull date 1/29/01 Installed by:

Improvement Permit by: C. [illegible] date 1/6/01 Operation Permit by: date

Authorization to Construct by: date Existing System Inspection by: date

HEALTH DEPT. COPY: WHITE OWNER COPY (FINAL): YELLOW OWNER COPY (INITIAL): PINK