IREDELL COUNTY HEALTH DEPARTMENT

ATESVIL 378-5305 MOORESVILLE 704-664-5281

IMPROVEMENT PERMIT / AUTHORIZATION TO CON / UCT / OPERATION PERMIT / EXISTING SYSTEM INSPECTION

PERMIT# 92956 PIN# ~~4679 00 9878~~ PT 4679-72-0172 DATE 9/7/04

OWNER OR CONTRACTOR Fleetwood Homes PHONE: Business 2492-7773 Home

ADDRESS 1040 Charlotte Hwy Troutman NC

LOCATION 801 N, TL Tripplett, TL Mallard Wood, on RF

SUBDIVISION Beechwood Est. BLOCK / SECTION LOT 9 LOT AREA 1.11 Ac SITE CLASS. PS DESIGN FLOW 480 L.T.A.R. 0.3

Septic Tank: 1000 Gallons; STB 1012 Date 5/4/04
Pump Tank: Gallons; PT Date
Pump Make: Model Serial No.
Nitrification Field: No Fields 1 Square Feet 1200 Linear Feet 400
No Lines 5 @ 80' Trench Width 36" Max Trench Bottom Depth 36"

☒ New System ☐ Repair System Type: I, II, III, IV, V, VI
System Description: Gravity 25% Reduct.
Repair System Description: Panel Block
Maintenance Agreement Required: ☐ Yes ☒ No

☐ House/Mod. Home ☒ Mobile Home ☐ Business ☐ Other
No. Bedrooms 4 No. Bathrooms No. Employees

Water Supply: ☒ Individual ☐ Public ☐ Community


Gravel Depth — ☐ Slab ☒ Crawl Space ☐ Basement w/plumbing ☐ Basement wo/plumbing

Comments:/Conditions:
Drive & Tank Location Switched


Comments:/Conditions:

1"=50'

INITIAL SITE SKETCH

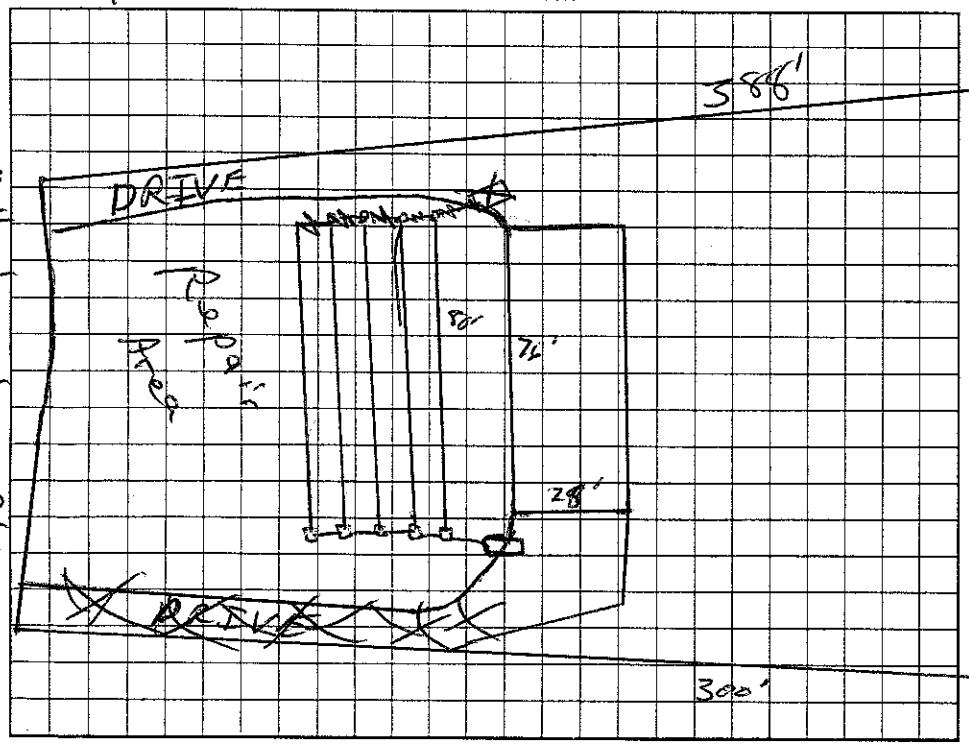

AS BUILT SKETCH

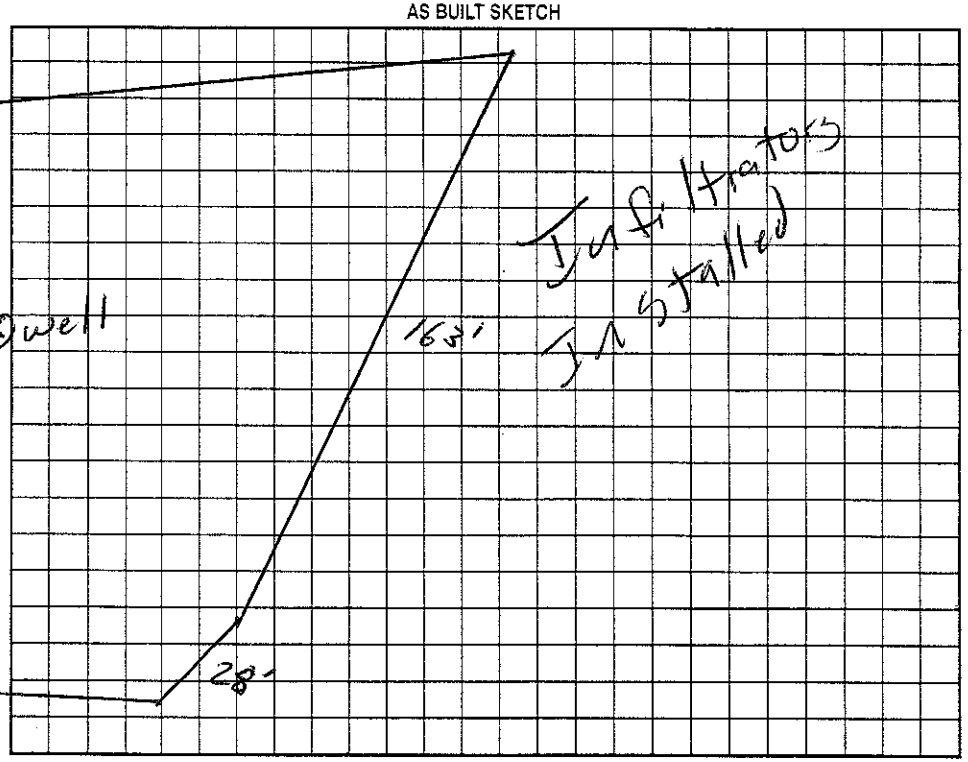

Permit can be suspended or revoked if any false information is supplied toward securing the permit/any unauthorized changes are made to the site/any unauthorized changes are made in the installation of the system. Improvement Permit with plat valid without expiration. Improvement Permit with site plan valid for sixty months. Authorization to Construct is valid for a period equal to that of Improvement Permit – not to exceed sixty months.

Signed: David Lykins date 9/9/04 Installed by: A-1 Backhoe

Improvement Permit by: RS date 9/7/04 Operation Permit by: RS date 9/16/04

Authorization to Construct by: RS date 9/7/04 Existing System Inspection by: date

HEALTH DEPT. COPY: WHITE OWNER COPY (FINAL): YELLOW OWNER COPY (INITIAL): PINK