4647-87-5538

IREDELL COUNTY HEALTH DEPARTMENT

STATESVILLE 704-878-5305 ∅ MOORESVILLE 704-664-5281

IMPROVEMENT PERMIT / AUTHORIZATION TO CONSTRUCT / OPERATION PERMIT / EXISTING SYSTEM INSPECTION

PERMIT# 115009 PIN# 4647-87-6975.15 DATE 8/11/03

OWNER OR CONTRACTOR Tyron Stowe PHONE: Business 704 872-3015 Home

ADDRESS 122 Felicity Ln. Mooresville NC 28115

LOCATION 21 N, TL Oates Rd, on Rt past Taldert.

SUBDIVISION Scarlet Oaks MHP BLOCK / SECTION LOT 15 LOT AREA SITE CLASS. PS DESIGN FLOW 360 L.T.A.R.

Septic Tank: Existing Gallons: STB Date

Pump Tank: Gallons: PT Date

Pump Make: Model Serial No.

Nitrification Field: No Fields Square Feet Linear Feet

No Lines Trench Width Max Trench Bottom Depth Gravel Depth

☐ New System ☐ Repair System Type: I, II, III, IV, V, VI

System Description: Ex. Convent. Bed

Repair System Description:

Maintenance Agreement Required: ☐ Yes ☑ No

☐ House/Mod. Home ☒ Mobile Home ☐ Business ☐ Other

No. Bedrooms 3 No. Bathrooms 2 No. Employees


☐ Slab ☒ Crawl Space ☐ Basement w/plumbing ☐ Basement wo/plumbing

Water Supply: ☐ Individual ☐ Public ☒ Community

Comments:/Conditions:

Comments:/Conditions:

INITIAL SITE SKETCH

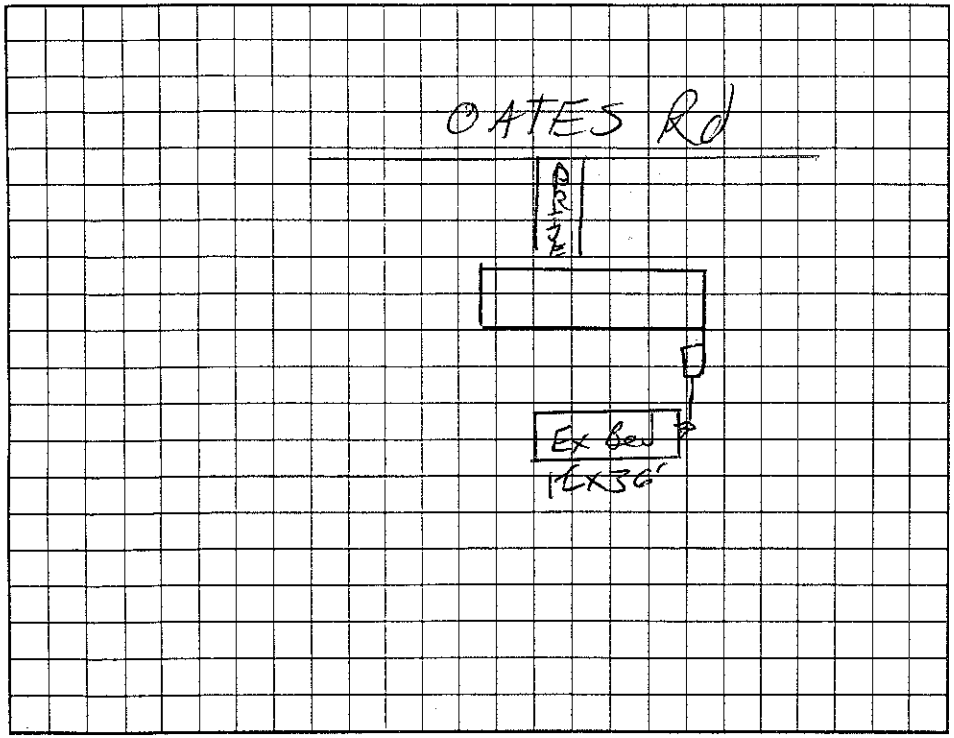

AS BUILT SKETCH

Permit can be suspended or revoked if any false information is supplied toward securing the permit/any unauthorized changes are made to the site/any unauthorized changes are made in the installation of the system. Improvement Permit with plat valid without expiration. Improvement ~~Permit with site plan~~ valid for sixty months. Authorization to Construct is valid for a period equal to that of Improvement Permit – not to exceed sixty months.

Signed: T. Tyron Stowe date 8-12-03

Installed by:

Improvement Permit by: date

Operation Permit by: date

Authorization to Construct by: date

Existing System Inspection by: RS date 8/11/03

HEALTH DEPT. COPY: WHITE OWNER COPY (FINAL): YELLOW OWNER COPY (INITIAL): PINK