4447-88-6258

IREDELL COUNTY HEALTH DEPARTMENT

STATESVILLE 704-878-5305 MOORESVILLE 704-664-5281

IMPROVEMENT PERMIT / AUTHORIZATION TO CONSTRUCT / OPERATION PERMIT / EXISTING SYSTEM INSPECTION

PERMIT# 55x3 PIN# 4647876975 DATE 7/6/98

OWNER OR CONTRACTOR Ricky Schumake PHONE: Business 662-8436 Home

ADDRESS P.O. 101 Mooresville, NC 28115

LOCATION 150 TR Talbert TL Stop Sign (Oates Rd) on Rt. Scarlett Rd

SUBDIVISION Scarlet Oaks BLOCK / SECTION — LOT 4 LOT AREA Exi SITE CLASS 9 DESIGN FLOW L.T.A.R.

Septic Tank: Gallons; STB Date

Pump Tank: Exist Gallons; PT Date

Pump Make: Model Serial No.

Nitrification Field; No Fields Square Feet Linear Feet

No Lines Exi Trench Width N/G Max Trench Bottom Depth Gravel Depth

☐ New System ☐ Repair System Type: I, II, III, IV, V, VI

System Description:

Repair System Description: Existing

Maintenance Agreement Required: ☐ Yes ☒ No

☐ House/Mod. Home ☒ Mobile Home ☐ Business ☐ Other

No. Bedrooms 3 No. Bathrooms 3 No. Employees


☐ Slab ☒ Crawl Space ☐ Basement w/plumbing ☐ Basement wo/plumbing

Water Supply: ☐ Individual ☐ Public ☒ Community

Comments:/Conditions: Septic System appears to be functioning Okay at time of inspection, No problems were Noticed. * Deep Drainfield.

Comments:/Conditions:

INITIAL SITE SKETCH Not to Scale

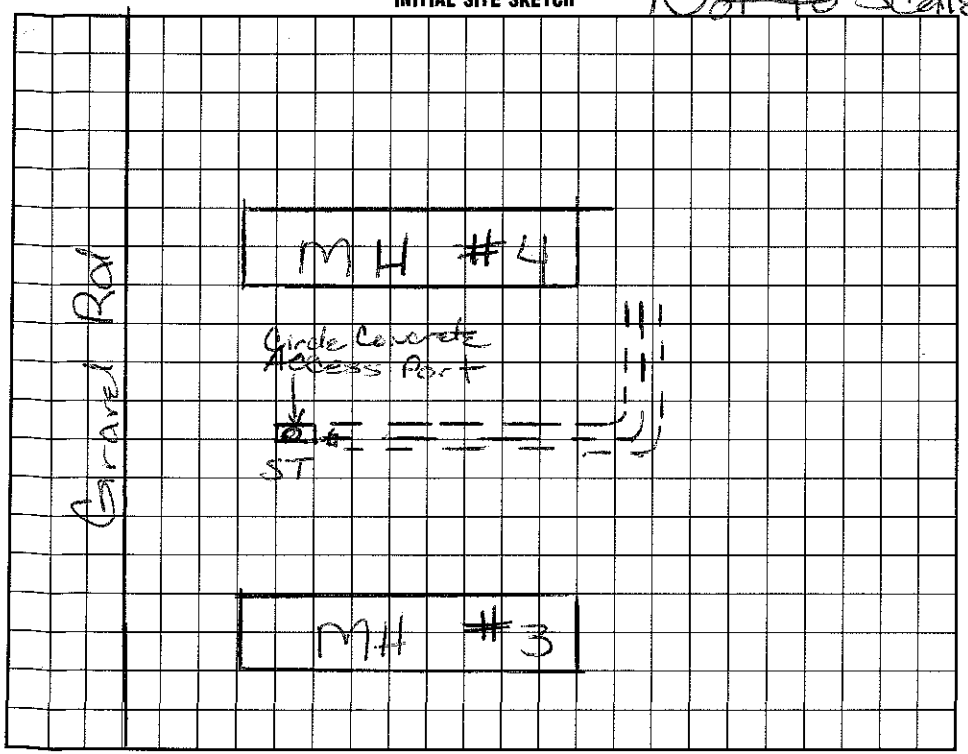

AS BUILT SKETCH

I understand that this permit can be suspended or revoked if any false information is supplied toward securing the permit/any unauthorized changes are made to the site/any unauthorized changes are made in the installation of the system. Improvement Permit with plat valid without expiration. Improvement Permit with site plan valid for sixty months. Authorization to Construct is valid for a period equal to that of Improvement Permit – not to exceed sixty months.

Signed: (Agent) date

Improvement Permit by: Marian H. Dotson date 7/6/98

Authorization to Construct by: Marian H. Dotson date 7/6/98

Installed by:

Operation Permit by: date

Existing System Inspection by: date

HEALTH DEPT. COPY: WHITE INSPECTION COPY (FINAL): GREEN OWNER COPY (FINAL): YELLOW INSPECTION COPY (INITIAL): PINK OWNER COPY (INITIAL): GOLD