IREDELL COUNTY HEALTH DEPARTMENT

Statesville Phone TR 3-7271 Mooresville Phone NO 3-1271

PERMIT TO INSTALL SEPTIC TANK

Permit NO._____ Permit Date 22 March 1965

Owner Carl Knox Builder Address Mooresville, NC

Installed By Oswalt Address Troutman, N.C.


Location of Property Terrace Acres Job # 3

Tank		Capacity		Length of Lines		Fixtures	
Block	(X)	800	( )	150'	( )	No. of Baths	( )
Precast	( )	900	( )	175'	( )	Dishwasher	( )
		1000	(X)	200'	( )	Garbage Grdr.	( )
		1100	( )	225'	(X)	Auto-Washer	( )
		1200	( )	250'	( )	Other_____	
		Other_____		Other_____			

NOTIFY HEALTH DEPARTMENT AT LEAST EIGHT HOURS BEFORE TANK IS TO BE INSPECTED.

Final Inspection 22 March 1965 Approved (✓) Disapproved ( )

Remarks_____

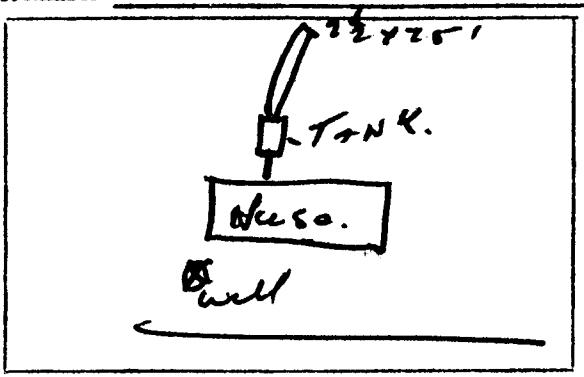

Sketch of Installation

Ray Scoggins RS

Sanitarian