IREDELL COUNTY HEALTH DEPARTMENT

STATESVILLE 704-878-5305 MOORESVILLE 704-664-5281

IMPROVEMENT PERMIT / CERTIFICATE OF COMPLETION / OPERATION PERMIT / EXISTING SYSTEM INSPECTION

PROPERTY DESCRIPTION NO. 20021 DATE 3/8/95 TAX MAP NO. 2P-1-A-21/22 Watershed: ☐ Yes ☑ No

OWNER OR CONTRACTOR Donald Wimbush ~~PHONE: Business~~ 4648-00-8914 Home 664-5155

ADDRESS 119 Pendland Ct. Mooresville, NC. 28115

LOCATION 150 YS TR Erwin Rd. drive on (R) before Lynnbrook Rd.

SUBDIVISION Lynbrook Acres BLOCK / SECTION _____ LOT Tract 1 LOT AREA 2.70 Ac SITE CLASS. P DESIGN FLOW 360 L.T.A.R. .3

Septic Tank: 1000 Gallons; STB _____ Date _____

Pump Tank: _____ Gallons; PT _____ Date _____

Pump Make: _____ Model _____ Serial No. _____

Nitrification Field: No Fields 1 Square Feet 1200 Linear Feet ~~*~~ 210

No Lines 3 Trench Width 24" Max Trench Bottom Depth 36" Gravel Depth 6" SAND

☑ New System ☐ Repair System Type: I, II, (III) IV, V, VI

System Description: Gravity-Panel

Repair System Description: Same

Maintenance Agreement Required: ☐ Yes ☐ No

☐ House/Mod. Home No. Bedrooms 3

☑ Mobile Home No. Bathrooms 2

☐ Business No. Employees _____

☐ Other _____


☐ Slab ☑ Crawl Space ☐ Basement w/plumbing ☐ Basement wo/plumbing

Water Supply: ☑ Individual ☐ Community ☐ Public

Comments: * 210 FT. 16" Prefab. Panel Blocks

Comments:

INITIAL SITE SKETCH

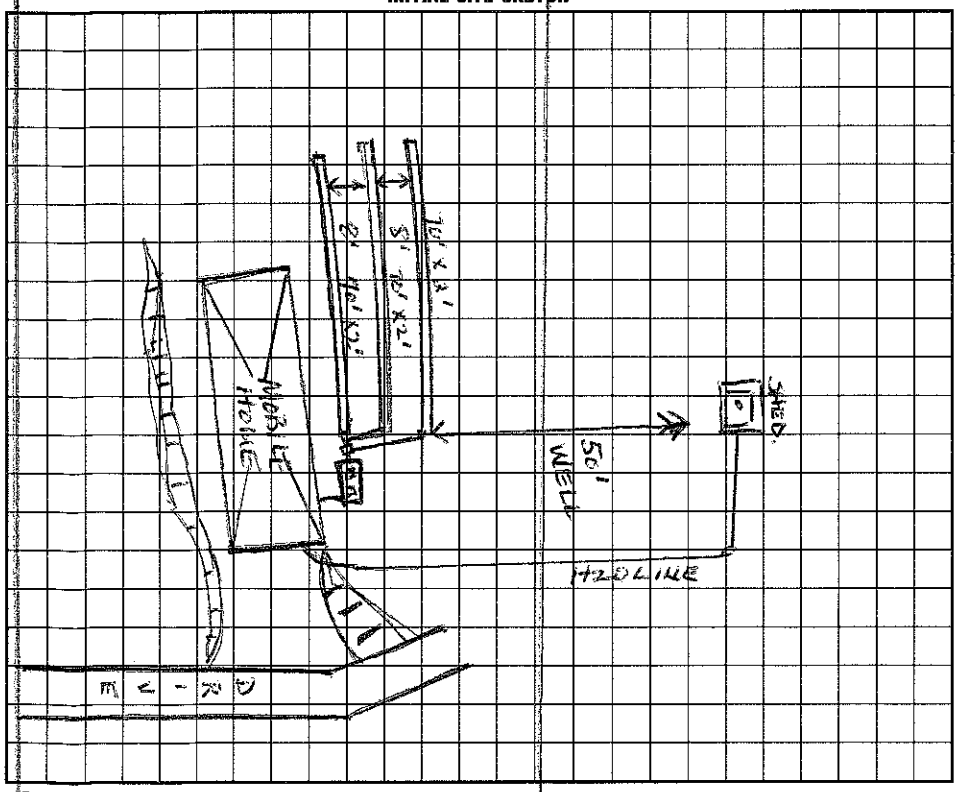

AS BUILT SKETCH

I understand that this permit can be suspended or revoked if any false information is supplied toward securing the permit/any unauthorized changes are made to the site/any unauthorized changes are made in the installation of the system. Improvement Permit is valid for 60 months from date of issuance.

Signed: _____

Improvement Permit by: Wesley Sparks RS. date 3/8/95

Existing System Inspection by: _____ date _____

Installed by: Richard Abernathy

Certificate of Completion by: Wesley Sparks RS. date 4/

Operation Permit by: _____ date

HEALTH DEPT. COPY: WHITE INSPECTION COPY (FINAL): GREEN OWNER COPY (FINAL): YELLOW INSPECTION COPY (INITIAL): PINK OWNER COPY (INIT