IREDELL COUNTY HEALTH DEPARTMENT

STATESVILLE 704-878-5305 $130 John 6 504 MOORESVILLE 704-664-5281

IMPROVEMENT PERMIT / AUTHORIZATION TO CONSTRUCT / OPERATION PERMIT / EXISTING SYSTEM INSPECTION

PERMIT# 118836 PIN# 4648029871 664-1382 Mike. DATE 3-2-04

OWNER OR CONTRACTOR James Williams PHONE: Business 664-3727 Home 662-0981 Jimmy

ADDRESS 620 Big Indian Loop Mooresville NC 28117

LOCATION Bluefield TL Big Indian Loop go straight to end TR 8th lot on left

SUBDIVISION CL&T BLOCK / SECTION 12 LOT 1072 LOT AREA .98 Acre SITE CLASS. PS DESIGN FLOW 480gpd L.T.A.R. .3

Septic Tank: 1000 Gallons; STB 825 Date 10/15/04
Pump Tank: 1000 Gallons; PT 302 Date 10/18/04
Pump Make: Zoeller Model N98 Serial No.
Nitrification Field: No Fields 1 Square Feet 1200' Linear Feet 400'
No Lines 3@133' Trench Width 36" Max Trench Bottom Depth 30'

☒ New System ☐ Repair System Type: I, II, (III) IV, V, VI
System Description: Pump - 25% Reduction
Repair System Description: Pump - Panel Blk
Maintenance Agreement Required: ☐ Yes ☒ No


☒ House/Mod. Home ☐ Mobile Home ☐ Business ☐ Other
No. Bedrooms 4 No. Bathrooms 4 No. Employees
Gravel Depth N/A ☐ Slab ☐ Crawl Space ☒ Basement w/plumbing ☐ Basement wo/plumbing

Water Supply: ☒ Individual ☐ Public ☐ Community

Comments:/Conditions:

Comments:/Conditions: *Do Not Cut House pad within 25Ft of Drainfield. Keep Septic System at least 10' from PL & 50' from lake.

INITIAL SITE SKETCH

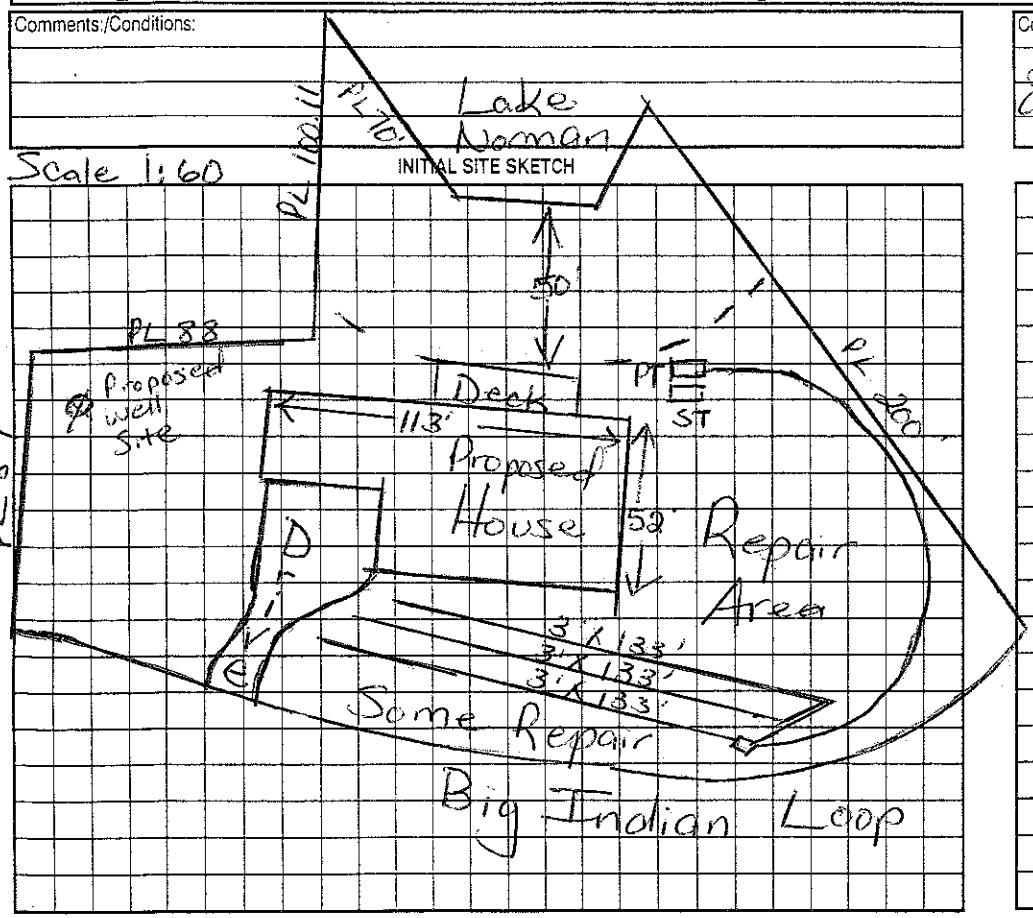

AS BUILT SKETCH

Infiltrators Installed

Permit can be suspended or revoked if any false information is supplied toward securing the permit/any unauthorized changes are made to the site/any unauthorized changes are made in the installation of the system. Improvement Permit with plat valid without expiration. Improvement Permit with site plan valid for sixty months. Authorization to Construct is valid for a period equal to that of Improvement Permit -- not to exceed sixty months.

Signed: X James Williams date

Improvement Permit by: Marvin Holman RS date 3/2/04

Authorization to Construct by: Marvin Holman RS date 3/2/04

Installed by: Rowan Septic

Operation Permit by: RS date 9/15/05

Existing System Inspection by: date

HEALTH DEPT. COPY: WHITE OWNER COPY (FINAL): YELLOW OWNER COPY (INITIAL): PINK